


STATE OF KANSAS
STATE CORPORATION COMMISSION
Give All Information Completely
Make Required Affidavit
Mail or Deliver Report to:
Conservation Division
State Corporation Commission
211 No. Broadway
Wichita, Kansas

WELL PLUGGING RECORD

Sumner County. Sec. 12 Twp. 32 Rge. 4 (E) 4 (W)
Location as "NE/CNW/SW" or footage from lines C SW SE
Lease Owner DONALD C. SLAWSON & KENNETH RUPP
Lease Name Bruce 'A' Well No. 1
Office Address 408 One Twenty Bldg., Wichita, Kansas
Character of Well (completed as Oil, Gas or Dry Hole) Dry Hole
Date well completed 11-24-65
Application for plugging filed 11-24-65
Application for plugging approved 11-24-65
Plugging commenced 11-24-65
Plugging completed 11-24-65
Reason for abandonment of well or producing formation D & A

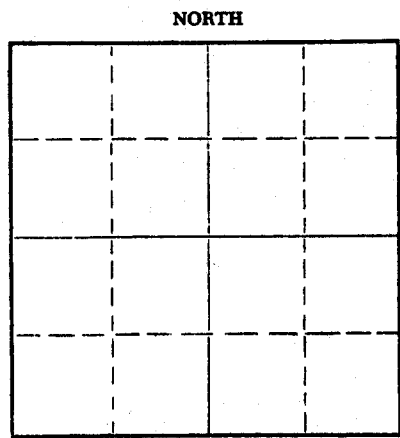

Locate well correctly on above Section Flat

If a producing well is abandoned, date of last production 19
Was permission obtained from the Conservation Division or its agents before plugging was commenced? Yes

Name of Conservation Agent who supervised plugging of this well H. E. Hess, 1422 Elizabeth, Winfield, Ks.
Producing formation _____ Depth to top _____ Bottom _____ Total Depth of Well 4392 Feet
Show depth and thickness of all water, oil and gas formations.

OIL, GAS OR WATER RECORDS				CASING RECORD		
FORMATION	CONTENT	FROM	TO	SIZE	PUT IN	PULLED OUT
				8-5/8"	244'	None

Describe in detail the manner in which the well was plugged, indicating where the mud fluid was placed and the method or methods used in introducing it into the hole. If cement or other plugs were used, state the character of same and depth placed, from _____ feet to _____ feet for each plug set.

Mud to 265', 1/2 sack hulls, set plug; 20 sacks regular cement; mud to 40'; 1/2 sack hulls, set plug; 8 sacks regular cement; 2 sacks regular cement in rat hole

RECEIVED
STATE CORPORATION COMMISSION
JAN 4 1966
CONSERVATION DIVISION
Wichita, Kansas

(If additional description is necessary, use BACK of this sheet)
Name of Plugging Contractor Slawson Drilling Co., Inc.
Address 408 One Twenty Building, Wichita, Kansas

STATE OF KANSAS COUNTY OF SEDGWICK, ss.
Donald C. Slawson (employee of owner) or (owner or operator) of the above-described well, being first duly sworn on oath, says: That I have knowledge of the facts, statements, and matters herein contained and the log of the above-described well as filed and that the same are true and correct. So help me God.

(Signature) [Signature]
408 One Twenty Bldg., Wichita, Ks.
(Address)

SUBSCRIBED AND SWORN to before me this 24th day of December, 19 65

My commission expires August 25, 1968
Ella Priess Notary Public.

WELL LOG

Company: DONALD C. SLAWSON
 408 One Twenty Building
 Wichita, Kansas

Farm: Bruce 'A' #1
 C SW SE, Section 12-32-4W
 Sumner County, Kansas

Total Depth: 4392' Elev. 1249 K.B.

Commenced: December 9, 1965
 Completed: December 24, 1965

Contractor: Slawson Drilling Co., Inc.

Casing: 8-5/8" @ 244' with 210 sacks of cement

0-20	Surface Clay
20-70	Shale & Shells
70-244	Lime & Shale
244-625	Shale & Shells
625-780	Lime
780-1880	Lime & Shale
1880-1915	Shale & Lime
1915-2050	Lime & Shale
2050-2150	Sand, Shale, Lime
2150-2255	Shale & Lime
2255-2570	Lime & Shale
2570-2627	Shale
2627-2657	Lime & Shale
2657-2849	Shale & Shells
2849-2962	Shale & Lime
2962-3000	Lime
3000-3082	Sand
3082-3269	Shale
3269-3535	Lime
3535-3556	Shale & Lime
3556-3608	Lime
3608-3920	Lime & Shale
3920-3931	Lime
3931-3934	Lime & Shale
3934-3999	Lime
3999-4019	Lime & Chert
4019-4293	Lime
4293-4353	Lime & Shale
4353-4370	Shale & Lime
4370-4392	Sand


RECEIVED
 STATE COMMISSION
 JAN 4 1966
 CONSERVATION DIVISION
 WICHITA, KANSAS

STATE OF KANSAS)
)SS:
 COUNTY OF SEDGWICK)

I, Donald C. Slawson, of the Slawson Drilling Company, Inc., upon oath state that the above and foregoing is a true and correct copy of the log of the Bruce 'A' #1 well.


 DONALD C. SLAWSON

Subscribed and sworn to before me this 3rd day of January, 1966.


 Ella Priess, Notary Public

My Commission Expires:
 August 25, 1968