


STATE OF KANSAS
STATE CORPORATION COMMISSION

WELL PLUGGING RECORD

Give All Information Completely
Make Required Affidavit
Mail or Deliver Report to:
Conservation Division
State Corporation Commission
212 North Market, Insurance Bldg.
Wichita, Kansas

SUMNER County, Sec. 16 Twp. 30S Rge. 1E (E) (W)

Location as "NE/CNW/SW" or footage from lines APPROX. NE NW NW
Lease Owner PETROLEUM, INC.
Lease Name SEYDELL Well No. 2
Office Address ROUTE 2, GREAT BEND, KANSAS
Character of Well (completed as Oil, Gas or Dry Hole) DRY HOLE
Date well completed SEPTEMBER 3 1960
Application for plugging filed SEPTEMBER 3 1960
Application for plugging approved SEPTEMBER 3 1960
Plugging commenced SEPTEMBER 3 1960
Plugging completed SEPTEMBER 3 1960
Reason for abandonment of well or producing formation NO PRODUCIBLE ZONES

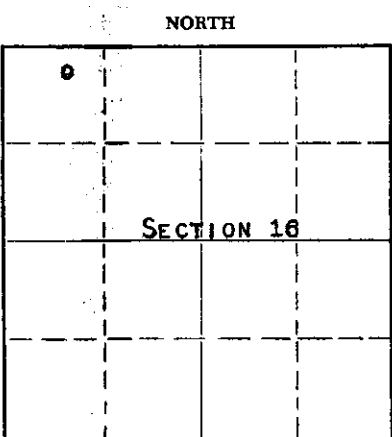

Locate well correctly on above Section Plat

If a producing well is abandoned, date of last production NONE 19
Was permission obtained from the Conservation Division or its agents before plugging was commenced? YES

Name of Conservation Agent who supervised plugging of this well LEE GUTHRIE
Producing formation _____ Depth to top _____ Bottom _____ Total Depth of Well 3826 Feet
Show depth and thickness of all water, oil and gas formations.

OIL, GAS OR WATER RECORDS

CASING RECORD

FORMATION	CONTENT	FROM	TO	SIZE	PUT IN	PULLED OUT
				8-5/8"	325'	NONE

Describe in detail the manner in which the well was plugged, indicating where the mud fluid was placed and the method or methods used in introducing it into the hole. If cement or other plugs were used, state the character of same and depth placed, from _____ feet to _____ feet for each plug set.

MUDDED UP WITH HEAVY MUD TO 300' FOLLOWED BY WOODEN PLUG. PLACED 20 SACKS CEMENT THROUGH DRILL PIPE ON TO PLUG. MUDDED UP WITH HEAVY MUD TO 35' FOLLOWED BY WOODEN PLUG AND 10 SACKS CEMENT TO BASE OF WELL CELLAR.

RECEIVED
STATE CORPORATION COMMISSION
SEP 27 1960
CONSERVATION DIVISION
Wichita, Kansas

(If additional description is necessary, use BACK of this sheet)

Name of Plugging Contractor GARVEY DRILLING COMPANY
Address ROUTE 2, GREAT BEND, KANSAS

STATE OF KANSAS, COUNTY OF BARTON, ss.
DON SEARLE (employee of owner) or (owner) of the above-described well, being first duly sworn on oath, says: That I have knowledge of the facts, statements, and matters herein contained and the log of the above-described well as filed and that the same are true and correct. So help me God.

(Signature) Don Searle

(Address)

SUBSCRIBED AND SWORN TO before me this 23RD day of SEPTEMBER, 19 60

Arthur J. Miles

My commission expires APRIL 14, 1963

Notary Public.



WELL LOG

15-191-10521-0000

COMPANY PETROLEUM, INCORPORATED

SEC. 16 T.30S R. 1E

FARM SEYDELL NO. 2


LOC. NE, NW, NW

TOTAL DEPTH 3826'

COUNTY SUMNER CO., KANSAS

COMM. August 23, 1960 COMP. September 3, 1960

CONTRACTOR GARVEY DRILLING COMPANY

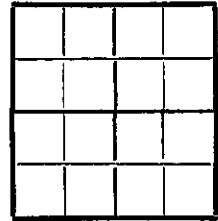

GAUGE 8 5/8" @ 325' w/225 sax.

ELEVATION 1235' DF

PRODUCTION D & A

FIGURES INDICATE BOTTOM OF FORMATIONS

180	Clay & sand
420	Lime & shale
445	Red bed
1100	Lime & shale
1160	Shale & lime
1490	Shale & shells
2415	Shale & lime
2545	Sand & shale
2778	Shale & sand
2883	Shale & lime
3250	Lime
3335	Lime w/shale streaks
3400	Lime w/chert streaks
3735	Lime
3782	Lime & shale
3796	Lime
3826	Simpson sand
3826	T. D.

RECEIVED
STATE CORPORATION COMMISSION
SEP 27 1960
CONSERVATION DIVISION
Wichita, Kansas

State of KANSAS }
County of BARTON } ss.

I, VERNE A. MORRIS of GARVEY DRILLING COMPANY

upon oath state that the above and foregoing is a true and correct copy of the log of the #2 SEYDELL well

Verne A. Morris

Subscribed and sworn to before me this 22nd day of September 19 60

My Commission Expires: April 14, 1963

Arthur J. Wales
NOTARY PUBLIC