


STATE OF KANSAS
STATE CORPORATION COMMISSION

Form CP-4

Give All Information Completely
Make Required Affidavit
Mail or Deliver Report to:
Conservation Division
State Corporation Commission
P. O. Box 17027
Wichita, Kansas 67217
NORTH

WELL PLUGGING RECORD

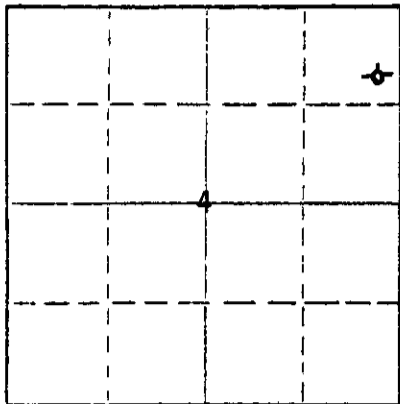

Locate well correctly on above
Section Plat

LANE County, Sec. 4 Twp. 19S Rgs. (E) 29W (W)
Location as "NE/CNW/SW" or footage from lines SE NE NE
Lease Owner DONALD C. SLAWSON
Lease Name McWhirter 'KK' Well No. 1
Office Address 200 Douglas Building
Character of Well (completed as Oil, Gas or Dry Hole) Dry Hole
Date well completed March 12, 19 82
Application for plugging filed March 12, 19 82
Application for plugging approved March 12, 19 82
Plugging commenced March 12, 19 82
Plugging completed March 12, 19 82
Reason for abandonment of well or producing formation Dry Hole

If a producing well is abandoned, date of last production 19
Was permission obtained from the Conservation Division or its agents before plugging was commenced? Yes

Name of Conservation Agent who supervised plugging of this well
Producing formation Depth to top Bottom Total Depth of Well 4690 Feet
Show depth and thickness of all water, oil and gas formations.

OIL, GAS OR WATER RECORDS

CASING RECORD

FORMATION	CONTENT	FROM	TO	SIZE	PUT IN	PULLED OUT
		surface	384'	8 5/8"		

Describe in detail the manner in which the well was plugged, indicating where the mud fluid was placed and the method or methods used in introducing it into the hole. If cement or other plugs were used, state the character of same and depth placed, from feet to feet for each plug set.

1st plug @ 825' w/70 sx
2nd plug @ 360' w/40 sx
Bridge @ 40' w/10 sx
10 sx in Rat Hole


RECEIVED
STATE CORPORATION COMMISSION
5-18-82
MAY 18 1982
CONSERVATION DIVISION
Wichita, Kansas

(If additional description is necessary, use BACK of this sheet)

Name of Plugging Contractor HALLIBURTON SERVICES
Address Box 579 Great Bend, Kansas 67530

STATE OF KANSAS, COUNTY OF SEDGWICK
agent for operator ss.
William R. Horigan

well, being first duly sworn on oath, says: That I have knowledge of the facts, statements, and matters herein contained and the log of the above-described well as filed and that the same are true and correct. So help me God.

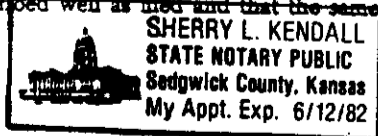

(Signature) William R. Horigan
William R. Horigan
200 Douglas Building Wichita, Kansas 67202
(Address)

SUBSCRIBED AND SWORN to before me this 5th day of May, 19 82

My commission expires 06/12/82

Sherry L. Kendall
Sherry L. Kendall Notary Public.