


STATE OF KANSAS  
STATE CORPORATION COMMISSION

WELL PLUGGING RECORD

Give All Information Completely  
Make Required Affidavit  
Mail or Deliver Report to  
Conservation Division  
State Corporation Comm.  
245 North Water  
Wichita, KS 67202

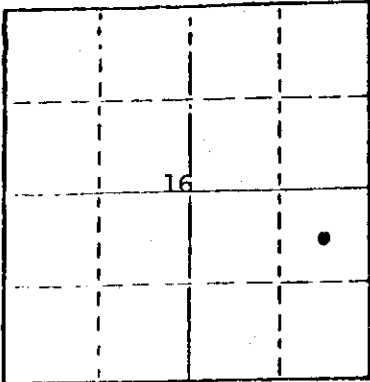

Locate well correctly on above  
Section Plot

Sumner County. Sec. 16 Twp. 34S Rge. 4 N/W  
Location as "NE/CNW/SW" or footage from lines  
C NE SE  
Lease Owner Anadarko Production Company  
Lease Name KOLARIK "A" Well No. 1  
Office Address P. O. Box 351, Liberal, Kansas 67901  
Character of Well (Completed as Oil, Gas or Dry Hole)  
Dry Hole  
Date Well completed 4-4 1980  
Application for plugging filed 5-21 1980  
Application for plugging approved 4-4 1980  
Plugging commenced 4-4 1980  
Plugging completed 4-4 1980  
Reason for abandonment of well or producing formation  
Dry Hole

If a producing well is abandoned, date of last production  
19

Was permission obtained from the Conservation Division or  
its agents before plugging was commenced? yes

Name of Conservation Agent who supervised plugging of this well Carl Barnett  
Producing formation Depth to top Bottom Total Depth of Well 4719'  
Show depth and thickness of all water, oil and gas formations.

OIL, GAS OR WATER RECORDS

CASING RECORD

FORMATION	CONTENT	FROM	TO	SIZE	PUT IN	PULLED OUT
				8-5/8"	323'	-0-

Describe in detail the manner in which the well was plugged, indicating where the mud fluid  
was placed and the method or methods used in introducing it into the hold. If cement or other  
plugs were used, state the character of same and depth placed, from feet to  
feet for each plug set.  
Spotted 50 sxs cmt @ 1800, 40 sxs cmt @ 330, 12 sxs 40-0', 3 sxs rathole w/hvy mud  
between all plugs.


(If additional description is necessary, use BACK of this sheet)

Name of Plugging Contractor Gabbert-Jones, Inc.

STATE OF KANSAS COUNTY OF SEWARD  
Paul Campbell (employee of owner) or  
of the above-described well, being first duly sworn on oath, says: that I have knowledge of  
the facts, statements, and matters herein contained and the log of the above-described well  
as filed and that the same are true and correct. So help me God.

(Signature) Paul Campbell  
P. O. Box 351, Liberal, Kansas 67901  
(Address)

SUBSCRIBED AND SWORN TO before me this 22<sup>nd</sup> day of May, 1980

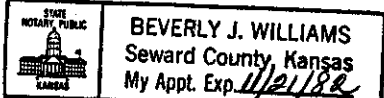

Beverly J. Williams  
Notary Public.

My commission expires November 21, 1982

## KANSAS

WELL COMPLETION REPORT AND  
DRILLER'S LOGAPI No. 15 — 191 — 21,025 0000  
County Number

## Operator

Anadarko Production Company

## Address

P. O. Box 351, Liberal, Kansas 67901

## Well No.

1

## Lease Name

KOLARIK "A"

## Footage Location

1980 feet from (M) (S) line 660 feet from (E) (M) line

## Principal Contractor

Gabbert-Jones, Inc.

## Geologist

## Spud Date

3/21/80

## Date Completed

4/4/80

## Total Depth

4719'

## P.B.T.D.

## Directional Deviation

1/2 deg @ 4719'


## Oil and/or Gas Purchaser

DRY HOLE

S. 16 T. 34S R. 4 ~~NE~~ W

Loc. C NE SE

County Summer

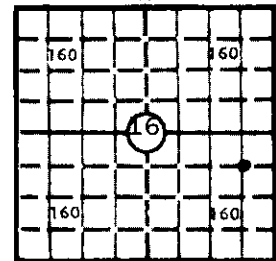640 Acres  
N

Locate well correctly

Elev.: Gr. 1225'

DF 1230' KB 1231'

## CASING RECORD

Report of all strings set — surface, intermediate, production, etc.

Purpose of string	Size hole drilled	Size casing set (in O.D.)	Weight lbs/ft.	Setting depth	Type cement	Sacks	Type and percent additives
Surface	12-1/4"	8-5/8"	20#	323'	Common	250	3% CaCl

## LINER RECORD

## PERFORATION RECORD

Top, ft.	Bottom, ft.	Sacks cement	Shots per ft.	Size & type	Depth interval

## TUBING RECORD

Size	Setting depth	Packer set at


## ACID, FRACTURE, SHOT, CEMENT SQUEEZE RECORD

Amount and kind of material used	Depth interval treated

## INITIAL PRODUCTION

Date of first production DRY HOLE	Producing method (flowing, pumping, gas lift, etc.)
RATE OF PRODUCTION PER 24 HOURS	Oil bbls. Gas MCF Water Gas-oil ratio CFPB
Disposition of gas (vented, used on lease or sold)	Production interval (s)

INSTRUCTIONS: As provided in KCC Rule 82-2-125, within 90 days after completion of a well, one completed copy of this Driller's Log shall be transmitted to the State Geological Survey of Kansas, 4150 Monroe Street, Wichita, Kansas 67209. Copies of this form are available from the Conservation Division, State Corporation Commission, 245 No. Water, Wichita, Kansas 67202. Phone AC 316-522-2206. If confidential custody is desired, please note Rule 82-2-125. Driller's Logs will be on open file in the Oil and Gas Division, State Geological Survey of Kansas, Lawrence, Kansas 66044.

Operator Anadarko Production Company		DESIGNATE TYPE OF COMP.: OIL, GAS, DRY HOLE, SWDW, ETC.:	
Well No. 1	Lease Name KOLARIK "A"		DRY HOLE
S 16 T 34S R 4 E W			
<b>WELL LOG</b>		SHOW GEOLOGICAL MARKERS, LOGS RUN, OR OTHER DESCRIPTIVE INFORMATION.	
Show all important zones of porosity and contents thereof; cored intervals, and all drill-stem tests, including depth interval tested, cushion used, time tool open, flowing and shut-in pressures, and recoveries.			
FORMATION DESCRIPTION, CONTENTS, ETC.	TOP	BOTTOM	NAME
Redbed	0'	323'	LOGS: Schlumberger Compensated Neutron- Formation Density Dual Induction-Log
Shale	323'	330'	
Shale, Sand	330'	880'	
Shale, Lime	880'	1165'	
Shale	1165'	2045'	
Shale, Lime	2045'	2275'	
Shale	2275'	2855'	
Lime, Shale	2855'	3960'	
Lime	3960'	4008'	
Shale, Lime	4008'	4070'	
Lime, Shale	4070'	4175'	
Lime	4175'	4719'	
TD		4719'	
USE ADDITIONAL SHEETS, IF NECESSARY, TO COMPLETE WELL RECORD.			
Date Received	<div style="text-align: center;">             Signature            Paul Campbell, Division Production Manager            Title            May 21, 1980            Date         </div>		