

Handwritten initials

STATE OF KANSAS
STATE CORPORATION COMMISSION

Form CP-4

Give All Information Completely
Make Required Affidavit
Mail or Deliver Report to:
Conservation Division
State Corporation Commission
212 No. Market
Wichita, Kansas

WELL PLUGGING RECORD

Sumner County, Sec. 2 Twp. 31 Rge. 2 (E) W (W)

Location as "NE/CNW/SE/SW" or footage from lines NE NE NE

Lease Owner Falcon Seaboard Drilling Company

Lease Name Myers Well No. 1

Office Address Box 3348 Houston, Texas 77001

Character of Well (completed as Oil, Gas or Dry Hole) Oil

Date well completed May 9 19 57

Application for plugging filed July 30 19 68

Application for plugging approved August 4 19 68


Plugging commenced August 12 19 68

Plugging completed August 18 19 68

Reason for abandonment of well or producing formation No longer a producer

If a producing well is abandoned, date of last production July 15 19 68

Was permission obtained from the Conservation Division or its agents before plugging was commenced? Yes

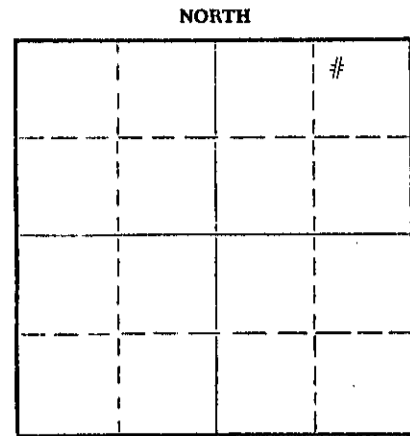

Locate well correctly on above Section Plat

Name of Conservation Agent who supervised plugging of this well Howard Hess

Producing formation _____ Depth to top _____ Bottom _____ Total Depth of Well 3839' Feet

Show depth and thickness of all water, oil and gas formations.

OIL, GAS OR WATER RECORDS

CASING RECORD

FORMATION	CONTENT	FROM	TO	SIZE	PUT IN	PULLED OUT
				10 3/4	558'	None
				5 1/2	3839'	2685'

Describe in detail the manner in which the well was plugged, indicating where the mud fluid was placed and the method or methods used in introducing it into the hole. If cement or other plugs were used, state the character of same and depth placed, from _____ feet to _____ feet for each plug set.

Plugged back with sand from 3839' to 3800'. Mixed and dumped 5 sx.

of cement from 3800' to 3760'. Pulled casing. Mudded hole to 260'

Mixed and dumped 25 sx. of cement from 250' to 200'. Mudded hole from

200' to 30'. Set 10' rock bridge from 30' to 20'. Mixed and dumped

8 sx. of cement from 20' to base of cellar.

RECEIVED
STATE CORPORATION COMMISSION
SEP 23 1968
CONSERVATION DIVISION
Wichita, Kansas

(If additional description is necessary, use BACK of this sheet)

Name of Plugging Contractor Russ Casing Pulling, Inc.

Address Box 1082 Great Bend, Kansas

STATE OF Texas, COUNTY OF HARRIS, ss.

J. A. Couvillon, Division Engineer (employee of owner) or (owner or operator) of the above-described

well, being first duly sworn on oath, says: That I have knowledge of the facts, statements, and matters herein contained and the log of the above-described well as filed and that the same are true and correct. So help me God

(Signature)

J. A. Couvillon
Box 3348 Houston, Texas 77001

(Address)

SUBSCRIBED AND SWORN to before me this 20 day of September, 1968

Imogene Philp
Imogene Philp
Notary Public.

My commission expires June 1969

WELL LOG BUREAU—KANSAS GEOLOGICAL SOCIETY
500 East Murdock, Wichita, Kansas

15-191-01303-0000


COPY

Company- FALCON SEABOARD DRILLING CO.
Farm- Myers No. 1

SEC. 2 T. 31 R. 2W
NE NE NE

Total Depth. 3040'
Comm. 10-26-57 Comp. 11-9-57
Shot or Treated.
Contractor. Falcon Seaboard Drig. Co.
Issued. 5-30-59

County Sumner
KANSAS

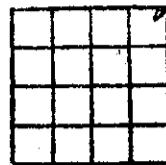

Elevation. 1331' DF

Production. 15 BOPD

CASING:

10 3/4" @ 558'
5 1/2" @ 3039'

Figures Indicate Bottom of Formations.

surface soil & red bed	67
shale & lime shells	507
lime & shale	2591
shale	2691
shale, sand & lime	2932
shale	3117
lime	3308
lime & shale	3786
lime	3840
Total Depth	

TOPS: SCOUT	
Lansing	3095
Mississippi	3750

RECEIVED
STATE CORPORATION COMMISSION
AUG 12 1968
CONSERVATION DIVISION
Wichita, Kansas