


STATE OF KANSAS
STATE CORPORATION COMMISSION

Form CP-4

WELL PLUGGING RECORD

Give All Information Completely
Make Required Affidavit
Mail or Deliver Report to:
Conservation Division
State Corporation Commission
211 No. Broadway
Wichita, Kansas

Location as "NE/CNW/SW" or footage from lines _____
Sumner County, Sec. 16 Twp. 31S Rge. (E) 2 (W) NW SE SE

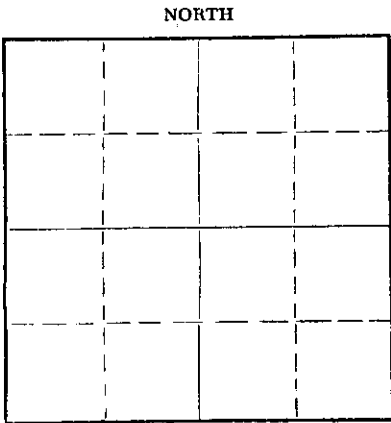

Locate well correctly on above Section Plat

Lease Owner A. C. Lawson
Lease Name Winn Well No. 2
Office Address RR #1, Geuda Springs, Kansas
Character of Well (completed as Oil, Gas or Dry Hole) Dry Hole
Date well completed December 14, 19 65
Application for plugging filed December 14, 19 65
Application for plugging approved December 14, 19 65
Plugging commenced December 13, 19 65
Plugging completed December 14, 19 65
Reason for abandonment of well or producing formation _____

If a producing well is abandoned, date of last production _____ 19 _____

Was permission obtained from the Conservation Division or its agents before plugging was commenced? Yes

Name of Conservation Agent who supervised plugging of this well Howard Hess, Winfield, Kansas

Producing formation _____ Depth to top _____ Bottom _____ Total Depth of Well 4211 Feet

Show depth and thickness of all water, oil and gas formations.

OIL, GAS OR WATER RECORDS

CASING RECORD

FORMATION	CONTENT	FROM	TO	SIZE	PUT IN	PULLED OUT
				8-5/8"	243'	None

Describe in detail the manner in which the well was plugged, indicating where the mud fluid was placed and the method or methods used in introducing it into the hole. If cement or other plugs were used, state the character of same and depth placed, from _____ feet to _____ feet for each plug set.

Mudded up with heavy mud to 264'. Followed by wooden plug and 1/4 sack hulls. Placed 20 sacks cement onto hulls. Mudded up with heavy mud to 40 feet followed by wooden plug, 1/2 sack hulls and 10 sacks cement to base of well cellar. Plugged rat hole with 2 sacks cement.

[Handwritten stamp]

DEC 27 1965 12-27-65

[Handwritten stamp]

(If additional description is necessary, use BACK of this sheet)

Name of Plugging Contractor Graves Drilling Co., Inc.
Address 412 Union Center, Wichita, Kansas

STATE OF KANSAS, COUNTY OF BUTLER, ss. John C. Graves (employee of owner) or (owner or operator) of the above-described well, being first duly sworn on oath, says: That I have knowledge of the facts, statements, and matters herein contained and the log of the above-described well as filed and that the same are true and correct. So help me God.

(Signature) *John C. Graves*
412 Union Center, Wichita, Kansas
(Address)

SUBSCRIBED AND SWORN TO before me this 23rd day of December, 19 65

My commission expires April 30, 1967

Betty Brandt Notary Public.

R O T A R Y D R I L L E R S ' L O G

OPERATOR: A. C. Lawson
RR #1
Geuda Springs, Kansas

DRILLING COMMENCED: December 4, 1965

CONTRACTOR: Graves Drilling Co., Inc.
412 Union Center
Wichita, Kansas

DRILLING COMPLETED: December 14, 1965

CASING RECORD: 9 Jts. 243' 8-5/8" with
150 sacks cement

LOCATION: Winn No. 2
NW SE SE
Section 16-31S-2W
Sumner County, Kansas

0 - 243	Soil & surface sand	3470 - 3577	Lime & shale
243 - 545	Red bed, lime & shale	3577 - 3761	Shale & lime
545 - 605	Lime & shale	3761 - 3780	Lime
605 - 930	Shale & lime	3780 - 3861	Lime & shale
930 - 1174	Lime & shale	3861 - 3903	Lime
1174 - 1740	Sand w/ lime stringers	3903 - 3921	Lime & shale
1740 - 2140	Lime & shale	3921 - 3956	Lime
2140 - 2259	Lime	3956 - 4130	Lime & shale
2259 - 2927	Shale & lime	4130 - 4140	Lime & chert
2927 - 2960	Shale	4140 - 4206	Shale
2960 - 3108	Shale w/ lime	4206 - 4211	Sand
3108 - 3470	Lime	4211	Rotary Total Depth

I hereby certify the foregoing statements to be true and correct to the best of my knowledge.

GRAVES DRILLING CO., INC.

By Phil Graves
President

RECEIVED
DEC 27 1965
REGISTRATION DIVISION
WICHITA, KANSAS

STATE OF KANSAS)
) SS:
BUTLER COUNTY)

Subscribed and sworn to before me, a Notary Public, this 23rd of December, 1965.

My commission expires:
April 30, 1967

Betty Brandt
Betty Brandt Notary Public