


15-191-21480-0000

WELL PLUGGING RECORD

Give All Information Completely
 Make Required Affidavit

COUNTY Sumner SEC. 26 TWP. 31S RGE. 2W ~~20W~~
 Location as in quarters or footage from lines:
 SE NW SW

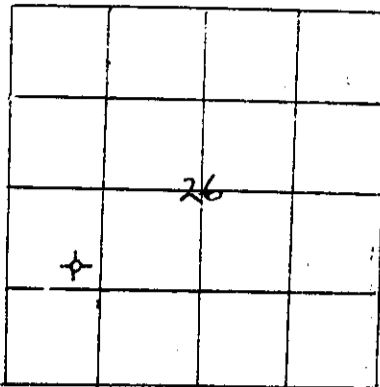

Lease Owner Midco Exploration, Inc.
 Lease Name Magnus Well No. 1
 Office Address 200 East First, Suite 411, Wichita, Kansas 67202
 Character of Well (Completed as Oil, Gas or Dry Hole): Dry Hole
 Date Well Completed 11/11/82
 Application for plugging filed 11/11/82
 Plugging commenced 11/11/82
 Plugging completed 11/11/82 3 p.m.
 Reason for abandonment of well or producing formation _____

Locate Well
 correctly on above
 Section Platt.

Was permission obtained from the Conservation Division or it's
 Agent's before plugging was commenced? Yes

Name of Conservation Agent who supervised plugging of this well _____

Producing formation _____ Depth to top _____ bottom _____ T.D. 4212

Show depth and thickness of all water, oil and gas formations.

OIL, GAS OR WATER RECORDS

Casing Record

Formation	Content	From	To	Size	Put in	Pulled Out
	Surf.Casing	0	288	8-5/8"	yes	no

Describe in detail the manner in which the well was plugged, indicating where the mud
 fluid was placed and the method or methods used in introducing it into the hold. If cement
 or other plugs were used, state the character of same and depth placed, from _____ feet
 to _____ feet for each plug set.

- 1st plug @ 325' with 30 sacks Common
- 2nd plug @ 60' with 20 sacks Common
- Bridge @ 40' with 10 sacks Common
- 10 sacks in rathole
- Plug down @ 3 p.m. 11/11/82

(If additional description is necessary, use BACK of this sheet)

Name of Plugging Contractor Allied Cementing Company

STATE OF Kansas COUNTY OF Sedgwick, ss.
Harvey Gough (~~employee of owner~~) or (~~owner or operator~~) of the

above-described well, being first duly sworn on oath, says: That I have knowledge of the
 facts, statements, and matters herein contained and the log of the above-described well as
 filed and that the same are true and correct. So help me God.

(Signature) Harvey Gough

 (Address)

SUBSCRIBED AND SWORN TO before me this 22nd. day of November, 19 82

My Commission expires: January 20, 1986

Barbara J. Jurowski

 Notary Public.

RECEIVED
 STATE CORPORATION COMMISSION

NOV 29 1982
 CONSERVATION DIVISION
 Wichita, Kansas