


STATE OF KANSAS
STATE CORPORATION COMMISSION

Form CP-4

WELL PLUGGING RECORD

Give All Information Completely
Make Required Affidavit
Mail or Deliver Report to:
Conservation Division
State Corporation Commission
212 No. Market
Wichita, Kansas 67202

NORTH

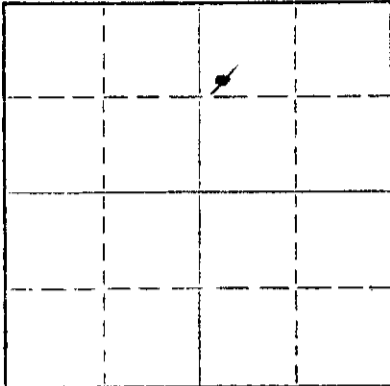

Locate well correctly on above
Section Plat

WABAUNSEE County. Sec. 29 Twp. 14S Rge. 10 (E) (W)
Location as "NE/CNW&SW" or footage from lines SW NW NE
Lease Owner MACK OIL CO.
Lease Name DROLL Well No. 2
Office Address Box 400 Duncan, Oklahoma 73533
Character of Well (completed as Oil, Gas or Dry Hole) Oil
Date well completed December 19 19 59
Application for plugging filed October 7 19 74
Application for plugging approved 10/22/74 & 8/12/75 19
Plugging commenced 8-11-75 19
Plugging completed 8-13-75 19
Reason for abandonment of well or producing formation Depleted

If a producing well is abandoned, date of last production _____ 19____
Was permission obtained from the Conservation Division or its agents before plugging was commenced? Yes

Name of Conservation Agent who supervised plugging of this well Mr. Merle Hickey
Producing formation Viola Depth to top 3261 Bottom 3266 Total Depth of Well 3266 Feet
Show depth and thickness of all water, oil and gas formations.

OIL, GAS OR WATER RECORDS

CASING RECORD

FORMATION	CONTENT	FROM	TD	SIZE	PUT IN	PULLED OUT
				8 5/8"	231	0
				4 1/2"	3261	3266

Describe in detail the manner in which the well was plugged, indicating where the mud fluid was placed and the method or methods used in introducing it into the hole. If cement or other plugs were used, state the character of same and depth placed, from _____ feet to _____ feet for each plug set.

8-11-75 Placed 5 sacks cement plug from TD up into casing.
8-12-75 Shot pipe at 2600' 2506' 2411' & 2100'. Worked pipe loose & pulled 67 jts. of casing.
8-13-75 Set rock bridge at 300', Dumped 5 yards ready mix in surface to cellar. Capped well.

08-26-75
BCB

(If additional description is necessary, use BACK of this sheet)

Name of Plugging Contractor Kelso Casing Pulling
Address P. O. Box 176 Chase, Kansas 67524

STATE OF Oklahoma COUNTY OF Stephens, ss.
_____, (employee of owner) or (owner or operator) of the above-described well, being first duly sworn on oath, says: That I have knowledge of the facts, statements, and matters herein contained and the log of the above-described well as filed and that the same are true and correct. So help me God.

(Signature) Carol A. Bentley
P.O. Box 400 Duncan, Okla 73533
(Address)

SUBSCRIBED AND SWORN TO before me this 25 day of August, 19 75

My commission expires 3-24-79
Josephine Bentley Notary Public.

COPY


WELL LOG BUREAU—KANSAS GEOLOGICAL SOCIETY
508 East Murdock, Wichita, Kansas

Company- **PURE OIL CO.**
Farm- **Drill** No. **2**

SEC. **29** T. **14** R. **10E**
SW NW NE

Total Depth. **3266'**
Comm. **12-8-59** Comp. **2-26-60**
Shot or Treated.
Contractor. **Shira Drig.**
Issued. **12-30-61**

County **Wabaunsee**
KANSAS

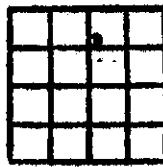

CASING:
8" **231'**
4" **3261'**

Elevation. **1497'**

Production. **76 BOFD**

Figures Indicate Bottom of Formations.

COMPLETE DRILLERS LOG NOT AVAILABLE.

TOPS: SCOUT	
Heebner	1364
Lansing	1660
Kansas City	1809
Mississippi	2592
Kinderhook	2897
Hunton	3050
Atoka	3181
Viola	3262

RECEIVED
STATE CORPORATION COMMISSION
OCT 22 1974
CONSERVATION DIVISION
Wichita, Kansas