


STATE OF KANSAS
STATE CORPORATION COMMISSION

WELL PLUGGING RECORD

Give All Information Completely
Make Required Affidavit
Mail or Deliver Report to
Conservation Division
State Corporation Comm.
245 North Water
Wichita, KS 67202

Sumner County, Sec. 19 Twp. 33S Rge. 3 ~~22W~~
Location as "NE/CNW $\frac{1}{4}$ /SW $\frac{1}{4}$ " or footage from lines _____
SE SW NW
Lease Owner Raymond Oil Company, Inc.
Lease Name Stewart Well No. 1-A
Office Address 200 W. Douglas, Suite 800, Wichita, Ks
Character of Well (Completed as Oil, Gas or Dry Hole) 67202
dry hole

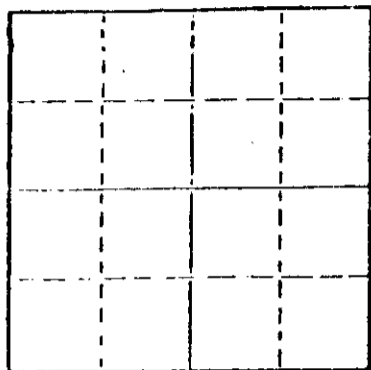

Locate well correctly on above
Section Plat

Date Well completed 5-19 1979
Application for plugging filed 5-19 1979
Application for plugging approved 5-19 1979
Plugging commenced 5-19 1979
Plugging completed 5-19 1979
Reason for abandonment of well or producing formation
no commercial quantities of oil or gas encountered
If a producing well is abandoned, date of last production
-- 19

Was permission obtained from the Conservation Division or
its agents before plugging was commenced? yes

Name of Conservation Agent who supervised plugging of this well Carl Barnett
Producing formation _____ Depth to top _____ Bottom _____ Total Depth of Well 4521
Show depth and thickness of all water, oil and gas formations.

OIL, GAS OR WATER RECORDS

CASING RECORD

FORMATION	CONTENT	FROM	TO	SIZE	PUT IN	PULLED OUT
surface hole	shale	surf	253	8-5/8	252	none

Describe in detail the manner in which the well was plugged, indicating where the mud fluid
was placed and the method or methods used in introducing it into the hold. If cement or other
plugs were used, state the character of same and depth placed, from _____ feet to
_____ feet for each plug set.

Fluid to 240', plug. 25 sx
Fluid to 40', plug. 15 sx
3 sx in rat hole

(If additional description is necessary, use BACK of this sheet)

Name of Plugging Contractor DNA Drilling, Inc.
515 R. H. Garvey Building
Wichita, Kansas 67202

STATE OF Kansas COUNTY OF Sedgwick, ss.
Ella Priess (employee of owner) or (owner or operator)
of the above-described well, being first duly sworn on oath, says: That I have knowledge of
the facts, statements, and matters herein contained and the log of the above-described well
as filed and that the same are true and correct. So help me God.

(Signature) Ella Priess
Suite 515 R.H. Garvey Bldg., Wichita, Ks. 67202
(Address)

SUBSCRIBED AND SWORN TO before me this 23rd day of May, 19 79

Dorothy L. Schmidt
Dorothy L. Schmidt Notary Public.

My commission expires April 30, 1983

DOROTHY L. SCHMIDT
STATE NOTARY PUBLIC
Sedgwick County, Kansas
My Appt. Exp. April 30, 1983

DRILLER'S LOG

RAYMOND OIL COMPANY, INC.
200 W. Douglas, Suite 800
Wichita, Kansas 67202

Elev: 1235 GL

No. 1-A Stewart
SE SW NW Sec. 19-338-3W
Sumner Co., Ks.

Surface Casing: 252' of 8-5/8"
cmtd w/200 sx, 3% cc

Commenced: 5-7-79
Completed: 5-19-79

FORMATION

DEPTH

Surface Hole	0 - 253
Red Bed & Shale	253 - 682
Shale, Lime & Sand	682 - 1037
Shale, Sand, & Lime	1037 - 1337
Lime	1337 - 1627
Shale	1627 - 1860
Shale & Lime	1860 - 2095
Shale, Sand & Lime	2095 - 2344
Shale & Lime	2344 - 3080
Lime & Shale	3080 - 3142
Shale & Lime	3142 - 3470
Lime	3470 - 3608
Lime & Shale	3608 - 3712
Shale & Lime	3712 - 3740
Lime & Shale	3740 - 3817
Lime	3817 - 3883
Shale & Lime	3883 - 3995
Lime & Shale	3995 - 4110
Lime	4110 - 4384
Lime & Shale	4384 - 4521 RTD

I do hereby certify that the foregoing statements are true and correct to the best of my knowledge and belief.

D N B DRILLING, INC.

Ella Priess

Ella Priess

MAY 20 1979

NOTARY PUBLIC
Wichita, Kansas

STATE OF KANSAS: ss:

Subscribed and sworn to before me this ~~29th~~ day of May, 1979.

Dorothy L. Schmidt
Dorothy L. Schmidt, Notary Public

DOROTHY L. SCHMIDT
STATE NOTARY PUBLIC
Sedgwick County, Kansas
My Appt. Exp. April 30, 1983