


Give All Information Completely
Make Required Affidavit
Mail or Deliver Report to:
Conservation Division
State Corporation Commission
211 No. Broadway
Wichita, Kansas

WELL PLUGGING RECORD

SUMNER County, Sec. 19 Twp. 33 Rge. (E) 3 (W)

Location as "NE/CNWxSWx" or footage from lines C-SE-SW
Lease Owner DOBSET COMPANY
Lease Name STEWART Well No. 2
Office Address 610 N. 1st Bk. of TULSA BLDG., TULSA, OKLA.
Character of Well (completed as Oil, Gas or Dry Hole) OIL
Date well completed _____ 19____
Application for plugging filed 10-13 1966
Application for plugging approved _____ 19____
Plugging commenced 10-15 1966
Plugging completed 10-18 1966
Reason for abandonment of well or producing formation DRY

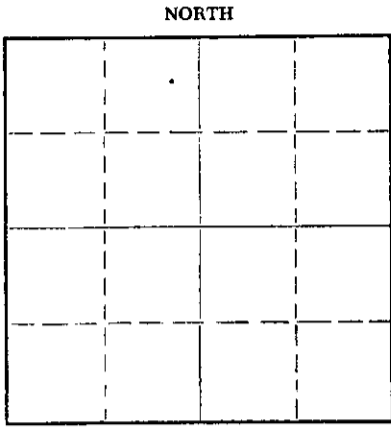

Locate well correctly on above Section Plat

If a producing well is abandoned, date of last production _____ 19____
Was permission obtained from the Conservation Division or its agents before plugging was commenced? YES

Name of Conservation Agent who supervised plugging of this well HOWARD HESS
Producing formation _____ Depth to top _____ Bottom _____ Total Depth of Well 4506 Feet
Show depth and thickness of all water, oil and gas formations.


OIL, GAS OR WATER RECORDS

CASING RECORD

FORMATION	CONTENT	FROM	TO	SIZE	PUT IN	PULLED OUT
				8-5/8"	242'	
				5 1/2"	4495'	3521'

Describe in detail the manner in which the well was plugged, indicating where the mud fluid was placed and the method or methods used in introducing it into the hole. If cement or other plugs were used, state the character of same and depth placed, from _____ feet to _____ feet for each plug set.

PLUG @ 4400', DUMPED 5 SACKS CEMENT
MUD TO 250'
BRIDGE TO 235'
DUMPED 20 SACKS CEMENT
MUD TO 20', CEMENT TO SURFACE WITH 4/8 SACKS CEMENT

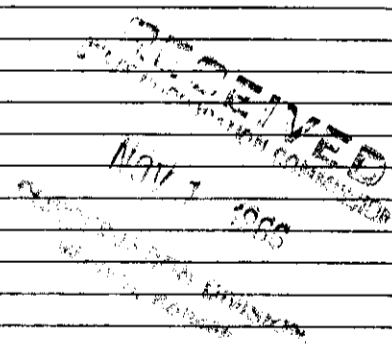

(If additional description is necessary, use BACK of this sheet)
Name of Plugging Contractor WINFIELD OIL FIELD SERVICE, INC.
Address P. O. Box 952, WINFIELD, KANSAS

STATE OF KANSAS, COUNTY OF COWLEY, ss.
CLEM S. KIER (employee of owner) or (owner or operator) of the above-described well, being first duly sworn on oath, says: That I have knowledge of the facts, statements, and matters herein contained and the log of the above-described well as filed and that the same are true and correct. So help me God.

(Signature) [Signature]
Box 952 Winfield Kansas (Address)

SUBSCRIBED AND SWORN TO before me this 29TH day of OCTOBER, 1966

Anna L. Smith
Notary Public.

My commission expires JULY 13, 1970

Dorset Co.

ROTARY DRILLING LOG

OWNER: Dorset Company
CONTRACTOR: Prime Drilling Company
LEASE: Stewart #2
LOCATION: C SE SW Section 19-33-2W
Sumner County, Kansas

CASING: Set 3 5/8" surface casing
@ 242', with 180 sacks
NA-5 Formin

0 - 70
70 - 242
242 - 985
985 - 1250
1250 - 1522
1522 - 1826
1826 - 1888
1888 - 2100
2100 - 2410
2410 - 2505
2505 - 2700
2700 - 3020
3020 - 3125
3125 - 3200
3200 - 3525
3525 - 3785
3785 - 3862
3862 - 4107
4107 - 4444
4444 - 4499

Soil & Shale
Red Bed
Shale & Shells
Anhydrite, Shale & Lime
Shale & Lime
Shale & Lime Streaks
Shale & Shells
Shale
Shale & Lime
Lime & Shale
Shale & Lime Streaks
Shale & Lime
Shale & Lime Streaks
Sand & Shale
Lime & Shale
Lime
Lime & Shale
Shale & Lime
Mississippi Lime
Shale & Lime
Rotary Total Depth

RECEIVED
CORPORATION COMMISSION
DEC 8 1966
CORPORATION DIVISION
Wichita, Kansas

Set 3 1/2" casing @ 4495',
with 75 sacks Formin

We certify that the above log is true and correct to the best of our knowledge and belief.

PRIME DRILLING COMPANY

BY *[Signature]*
L. S. Clappitt