

STATE OF KANSAS  
STATE CORPORATION COMMISSION  
200 Colorado Derby Bldg  
Wichita, Kansas 67202

WELL PLUGGING RECORD

Give All Information Completely  
Make Required Affidavit

COUNTY Sumner SEC. 6 TWP. 32S RGE. 3 E/WX  
Location as in quarters or footage from lines:

NW NW SE


Lease Owner Vincent Oil Corporation  
 Lease Name Bruce Well No. #1  
 Office Address 125 N. Market Suite 1110 Wichita, Ks. 67202  
 Character of Well (Completed as Oil, Gas or Dry Hole): Dry  
 Date Well Completed 10-10-83  
 Application for plugging filed 10-10-83  
 Plugging commenced 10-10-83  
 Plugging completed 10-10-83  
 Reason for abandonment of well or producing formation \_\_\_\_\_

Locate Well  
correctly on above  
Section Platt.

Was permission obtained from the Conservation Division or it's  
Agent's before plugging was commenced? Yes

Name of Conservation Agent who supervised plugging of this well Glenn Ward

Producing formation \_\_\_\_\_ Depth to top \_\_\_\_\_ bottom T.D. 3440'

Show depth and thickness of all water, oil and gas formations.

OIL, GAS OR WATER RECORDS

Casing Record

Formation	Content	From	To	Size	Put in	Pulled Out
				8 5/8"	258'	NONE

Describe in detail the manner in which the well was plugged, indicating where the mud fluid was placed and the method or methods used in introducing it into the hold. If cement or other plugs were used, state the character of same and depth placed, from \_\_\_\_\_ feet to \_\_\_\_\_ feet for each plug set.

- Spotted 35 sx. cement @ 1250' thru drill pipe.
- Spotted 35 sx. cement @ 311' thru drill pipe.
- Spotted 25 sx. cement @ 60' thru drill pipe, circ. to surface.
- Spotted 10 sx. cement in rathole.


(If additional description is necessary, use BACK of this sheet)

Name of Plugging Contractor White & Ellis Drilling, Inc.  
401 E. Douglas, Suite 500, Wichita, Ks. 67202

STATE OF Kansas COUNTY OF Sedgwick, ss.  
Ernest Sifford (employee of owner) or (owner or operator) of the above-described well, being first duly sworn on oath, says: That I have knowledge of the facts, statements, and matters herein contained and the log of the above-described well as filed and that the same are true and correct. So help me God.

(Signature) Ernest Sifford  
401 E. Douglas #500 Wichita  
(Address) Kansas 67202

SUBSCRIBED AND SWORN TO before me this 27<sup>th</sup> day of October, 19 83

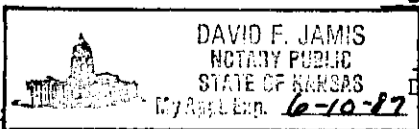


David F. Jamis  
David F. Jamis, Notary Public.

My Commission expires \_\_\_\_\_

RECEIVED  
STATE CORPORATION COMMISSION

OCT 31 1983

Wichita, Kansas

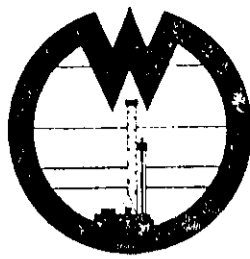

15-91-21601-0000

# WHITE

AND ELLIS DRILLING, Inc.

## DRILLERS LOG

OPERATOR: Vincent Oil Corporation 125 N. Market Suite - 1110 Wichita, Ks. 67202

CONTRACTOR: White & Ellis Drilling, Inc., 401 E. Douglas, Suite 500, Wichita, Ks. 67202

Lease Name Bruce Well No. #1

Sec. 6 T. 32S R. 3W Spot NW NW SE

County Sumner State Kansas Elevation \_\_\_\_\_

### Casing Record:

Surface: 8 5/8" @ 258' with 175 sx. 3%cc

Production: \_\_\_\_\_ @ \_\_\_\_\_ with \_\_\_\_\_ sx.

Type Well: D & A Total Depth 3440'

Drilling Commenced 10-2-83 Drilling Completed 10-9-83

Formation	From	To	Tops	
Cellar	0	7	Topeka	2335
Shale	7	261	Stalnaker	3007
Shale, Lime	261	1752	Lansing	3299
Shale, Sand, Lime	1752	1955		
Shale, Sand	1955	2122		
Lime, Shale	2122	2165		
Shale, Lime	2165	2335		
Lime	2335	2505		
Shale, Lime, Sand	2505	2599		
Shale, Sand	2599	2730		
Shale, Lime, Sand	2730	3007		
Sand	3007	3078		
Shale, Sand, Lime	3078	3212		
Shale	3212	3299		
Lime	3299	3440		

RECEIVED  
STATE CORPORATION COMMISSION

OCT 31 1983

CONSERVATION DIVISION  
Wichita, Kansas