


STATE OF KANSAS
STATE CORPORATION COMMISSION

WELL PLUGGING RECORD

Give All Information Completely
Make Required Affidavit
Mail or Deliver Report to:
Conservation Division
State Corporation Commission
211 No. Broadway
Wichita, Kansas

Sumner County, Sec. 2 Twp. 32S Rge. 2W

Location as "NE/CNW%SW%" or footage from lines NW NW NW
Lease Owner Capitt Drilling, Inc., R. W. Thomas, et al
Lease Name Belsley-Foster Well No. 1
Office Address 814 Union Center, Wichita, Kansas
Character of Well (completed as Oil, Gas or Dry Hole) Dry Hole
Date well completed December 26 1957
Application for plugging filed December 26 1957
Application for plugging approved December 26 1957
Plugging commenced December 26 1957
Plugging completed December 26 1957
Reason for abandonment of well or producing formation no oil in commercial quantities found

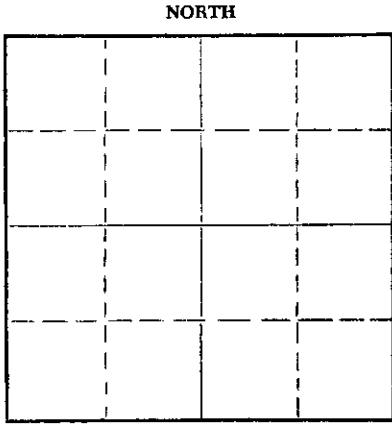

Locate well correctly on above Section Plat

If a producing well is abandoned, date of last production 19
Was permission obtained from the Conservation Division or its agents before plugging was commenced? yes

Name of Conservation Agent who supervised plugging of this well Eugene Graham
Producing formation _____ Depth to top _____ Bottom _____ Total Depth of Well 3916 Feet
Show depth and thickness of all water, oil and gas formations.

OIL, GAS OR WATER RECORDS

CASING RECORD

FORMATION	CONTENT	FROM	TO	SIZE	PUT IN	PULLED OUT
				8-5/8"	295'	none

Describe in detail the manner in which the well was plugged, indicating where the mud fluid was placed and the method or methods used in introducing it into the hole. If cement or other plugs were used, state the character of same and depth placed, from _____ feet to _____ feet for each plug set.

Filled hole with extra heavy rotary mud from total depth (3916') to 240'. Set Plug #1 at 240' and 15 sacks cement. Filled hole with extra heavy rotary mud from Plug #1 to 40'. Set Plug #2 and 10 sacks cement at 40'.

RECEIVED
STATE CORPORATION COMMISSION
JAN 2 1958
CONSERVATION DIVISION
Wichita, Kansas

(If additional description is necessary, use BACK of this sheet)

Name of Plugging Contractor Capitt Drilling, Inc.
Address 814 Union Center, Wichita, Kansas

STATE OF KANSAS, COUNTY OF Sedgwick, ss.
R. R. McNicol (employee of owner) or (owner or operator) of the above-described well, being first duly sworn on oath, says: That I have knowledge of the facts, statements, and matters herein contained and the log of the above-described well as filed and that the same are true and correct. So help me God.

(Signature) R. R. McNicol
814 Union Center, Wichita, Kansas
(Address)

SUBSCRIBED AND SWORN TO before me this 30th day of December, 19 57

Darlene May
Darlene May
Notary Public.

My commission expires September 30, 1959

PLUGGING
NO. 2 132 R 24
BOOK PAGE 72 LINE 18

ROTARY DRILLING LOG

OPERATOR: Capitt Drilling, Inc. & R. W. Thomas, et al

CONTRACTOR: Capitt Drilling, Inc.
COMM: 12/13/57
COMP: 12/26/57

BELSLEY-FOSTER No. 1
NW NW NW Sec. 2-32S-2W,
Sumner County, Kansas

Remarks: Set 8-5/8" casing at 295'
cemented with 250 sacks cement.

Formations:

Clay & Shale	25'
Sand	40'
Shale & Shells	295'
Shale	455'
Shale & Shells	580'
Lime w/Shale Breaks	856'
Shale & Shells	990'
Lime W/Shale (Breaks)	1105'
Shale & Lime Shells	1270'
Lime w/Shale Breaks	1425'
Shale & Shells	1660'
Shale w/Lime (Streaks)	1780'
Shale & Lime Shells	1935'
Shale & Shells	1961'
Lime w/Shale (Breaks)	2045'
Lime	2221'
Shale & Lime	2849'
Sand	2930'
Sand & Sandy Shale	3025'
Shale	3162'
Lime	3422'
Shale & Lime	3454'
Sand & Shale	3471'
Shale & Lime	3522'
Lime	3577'
Shale & Lime	3621'
Lime & Shale	3649'
Lime	3838'
Lime Chert	3850'
Lime	3916'
Rotary Total Depth (D&A)	3916'

We certify the above log is true and correct to the best of our knowledge and belief.

CAPITT DRILLING, INC.

R.R. McNicol

R. R. McNicol

STATE OF KANSAS
DEPARTMENT OF GEOLOGY
DIVISION OF OIL AND GAS
RECORDS SECTION

RECORDED
2 32 2W
72 18