

STATE OF KANSAS
STATE CORPORATION COMMISSION


Give All Information Completely
Make Required Affidavit
Mail or Deliver Report to:
Conservation Division
State Corporation Commission
211 No. Broadway
Wichita, Kansas

15-101-00005-0000
WELL PLUGGING RECORD

Lane _____ County, Sec. 2 Twp. 19S Rge. 29 (E) W (W)

Location as "NE/CNW/SW" or footage from lines C SE SE
Lease Owner Pet-Ex Company
Lease Name Mumma Well No. 1
Office Address 705 Union Center, Wichita, Kansas
Character of Well (completed as Oil, Gas or Dry Hole) Dry Hole
Date well completed 2-4 19 61
Application for plugging filed 2-4 19 61
Application for plugging approved 2-4 19 61
Plugging commenced 2-4 19 61
Plugging completed 2-4 19 61
Reason for abandonment of well or producing formation D & A

NORTH

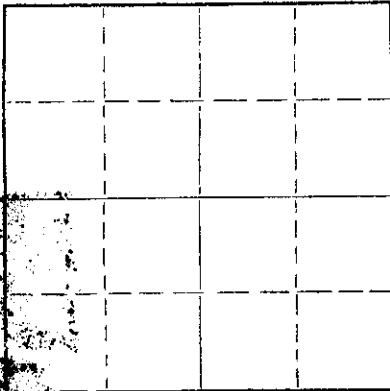

Locate well correctly on above
Section Plat

If a producing well is abandoned, date of last production _____ 19____
Was permission obtained from the Conservation Division or its agents before plugging was commenced? Yes

Name of Conservation Agent who supervised plugging of this well Gilbert Leiker
Producing formation _____ Depth to top _____ Bottom _____ Total Depth of Well 4735 Feet
Show depth and thickness of all water, oil and gas formations.

OIL, GAS OR WATER RECORDS

CASING RECORD

FORMATION	CONTENT	FROM	TO	SIZE	PUT IN	PULLED OUT
				8 5/8"	277'	-0-

Describe in detail the manner in which the well was plugged, indicating where the mud fluid was placed and the method or methods used in introducing it into the hole. If cement or other plugs were used, state the character of same and depth placed, from _____ feet to _____ feet for each plug set.

Filled with heavy mud to 277'. Set bottom plug @ 277' w/ 1/2 sx hulls and 20 sx cement. Set top plug @ 40' w/ 1/2 sx hulls and 10 sx cement.

RECEIVED
STATE CORPORATION COMMISSION

JUN 29 1961
6-29-61
CONSERVATION DIVISION
Wichita, Kansas

(If additional description is necessary, use BACK of this sheet)

Name of Plugging Contractor Red Tiger Drilling Company
Address Box 173, Russell, Kansas

STATE OF KANSAS, COUNTY OF SEDGWICK, ss.

(~~employee of owner~~) or (owner or operator) of the above-described well, being first duly sworn on oath, says: That I have knowledge of the facts, statements, and matters herein contained and the log of the above-described well as filed and that the same are true and correct. So help me God.

(Signature) [Signature]
705 Union Center, Wichita, Kansas
(Address)

SUBSCRIBED AND SWORN TO before me this 28th day of June, 19 61

My commission expires Sept. 14, 1964

[Signature]
Beverly M. Peterson
Notary Public.



DRILLERS LOG

15101-00005-0000

No. 1 Mumma

CASING RECORD:

COMPANY: Pet-Ex

DESCRIPTION: C SE SE
2-19E-29W
Lane
County,
Kansas

8 5/8" @ 277'
w/225 sx cement

CONTRACTOR: Red Tiger Drilling Co.

COMMENCED: January 22, 1961

TOTAL DEPTH: 4735'

COMPLETED: February 4, 1961

ELEVATION:

FORMATION

FROM

TO

REMARKS

Soil	0	5
Clay	5	25
Shale	25	277
Shale & Shells	277	765
Sand	765	835
Shale & Shells	835	900
Sand Shale	900	1290
Shale & Shells	1290	1740
Red Bed & Shale	1740	2000
Shale & Shells	2000	2145
Anhydrite	2145	2187
Shale & Shells	2187	2650
Shale & Lime	2650	3880
Lime	3880	4415
Lime & Shale	4415	4555
Lime	4555	4595
Lime & Chirt	4595	4642
Lime	4642	4735

RECEIVED
STATE CORPORATION COMMISSION

JUN 20 1961

CONSERVATION DIVISION
Wichita, Kansas

I certify that this is a true and correct copy of the above log to the best of my knowledge.

RED TIGER DRILLING COMPANY

George A. Angle
George A. Angle

Subscribed and sworn to before me this 7th day of February, 1961.

Maxine Head
Notary Public

My Commission Expires:

11-17-62