


WELL PLUGGING RECORD

Give All Information Completely
Make Required Affidavit
Mail or Deliver Report to:
Conservation Division
State Corporation Commission
211 No. Broadway
Wichita, Kansas

NORTH

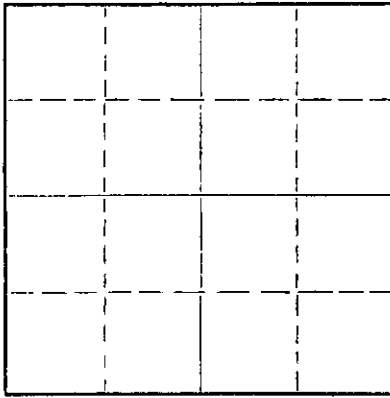

Locate well correctly on above Section Plat

Sumner County, Sec. 2 Twp. 23S Rge. 4 (X) W (W)
Location as "NE/CNW/SW" or footage from lines SW SW NW
Lease Owner E. H. Adair Oil Company
Lease Name STEPHENS Well No. 1
Office Address 1017 E. Second St., Wichita, Ks.
Character of Well (completed as Oil, Gas or Dry Hole) Dry Hole
Date well completed 1/10/57 19
Application for plugging filed 1/10/58 19
Application for plugging approved 1/10/57 19
Plugging commenced 1/10/57 19
Plugging completed 1/10/57 19
Reason for abandonment of well or producing formation Dry Hole

If a producing well is abandoned, date of last production _____ 19____
Was permission obtained from the Conservation Division or its agents before plugging was commenced? Yes

Name of Conservation Agent who supervised plugging of this well W. G. Buffington, R.R. #2, Geuda Springs, Ks.
Producing formation _____ Depth to top _____ Bottom _____ Total Depth of Well 4481 Feet
Show depth and thickness of all water, oil and gas formations.

OIL, GAS OR WATER RECORDS

CASING RECORD

FORMATION	CONTENT	FROM	TO	SIZE	PUT IN	PULLED OUT
<u>Sand, Shale</u>		<u>0</u>	<u>224*</u>	<u>8-5/8"</u>	<u>224*</u>	<u>0</u>

Describe in detail the manner in which the well was plugged, indicating where the mud fluid was placed and the method or methods used in introducing it into the hole. If cement or other plugs were used, state the character of same and depth placed, from _____ feet to _____ feet for each plug set.

Plugged hole, Bottom plug @ 220* W/15 sacks cement, Top plug @ 30* W/10sacks cement, Plug down @ 4:00A.M.

(If additional description is necessary, use BACK of this sheet)

Name of Plugging Contractor Graham-Michaelis Drilling Co.
Address 211 North Broadway, Wichita, Kansas


STATE OF KANSAS, COUNTY OF REDGWICK, ss.
V. D. Grier (employee of owner) of ~~XXXXXX~~ of the above-described well, being first duly sworn on oath, says: That I have knowledge of the facts, statements, and matters herein contained and the log of the above-described well as filed and that the same are true and correct. So help me God. Graham-Michaelis Drilling Co.

(Signature) V. D. Grier
211 North Broadway, Wichita, Kansas
(Address)

SUBSCRIBED AND SWORN TO before me this 17th day of January, 19 7

My commission expires 6/23/58

RECEIVED
STATE CORPORATION COMMISSION
Notary Public.

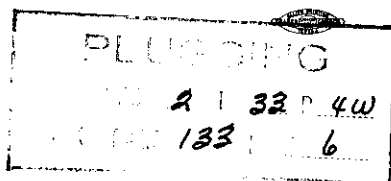

E. H. Adair Oil Company
1019 East Second St.
Wichita 7, Kansas.

E. H. Adair Oil Company &
A. F. Brann
No. 1 Stephens
SW SW NW of
Sec. 2-33-4West,
Sumner County, Kansas.

Elevation: 1261 K.B.

Comm.: 12-20-56
Comp.: 1-10/57
Contractor:
Graham-Michaelis Drig. Co.
8-5/8 @ 224 w/150 sax.

D. & A.

Figures indicate bottoms of formations

Sand & shale to	224	Shale & limey shale to	3668
Shale & redbeds	390	Shale	3680
Shale	803	Lime	3692
Shale & lime	1876	Shale	3722
Shale	2075	Lime	3747
Shale & lime	2900	Black shale	3750
Shale	3032	Shaley lime	3778
Lime	3036	Shale	3799
Shale	3074	Lime	3805
Lime	3077	Black shale	3811
Sand	3204	Lime	3815
Shaley Sand	3228	Shale	3824
Shale	3398	Lime	3842
Lime	3402	Black shale	3846
Shale	3406	Shaley lime	3897
Lime	3436	Shale & lime streaks	3975
Lime, cherty & slightly porous	3463	Shale	4073
Lime, dense	3468	Shaley Chert	4082
Shale	3474	Tripolitic Chert	4134
Lime, cherty	3497	Cherty lime	4198
Lime	3515	Cherty dolomitic porous lime	4214
Lime, oocastic	3529	Dense lime	4220
Lime	3557	Porous lime	4279
Black shale	3560	Lime	4289
Lime	3578	Shaley lime	4321
Shale	3584	Cherty lime	4325
Lime	3606	Shaley lime	4392
Black shale	3610	Shale	4476
Lime	3620	Sand	4481

Certified correct:

K. W. Johnson
K. W. Johnson - Geologist.

PLUGGING	
FILE SEC.	2 T 33 R 4 W
BOOK PAGE	133 LINE 6

RECEIVED
REGISTRATION COMMISSION

EB 19 1957

REGISTRATION DIVISION
Wichita, Kansas