

R

STATE OF KANSAS
STATE CORPORATION COMMISSION


WELL PLUGGING RECORD

Give All Information Completely
Make Required Affidavit
Mail or Deliver Report to:
Conservation Division
State Corporation Commission
211 No. Broadway
Wichita, Kansas

SUMNER County, Sec. 13 Twp. 32S Rge. (E)4 (W)

Location as "NE/CNW/SW" or footage from lines C SWSW
Lease Owner VANDEVER PETROLEUM CO.
Lease Name H. G. ALTMAN Well No. 1
Office Address 204 MAYO BLDG., TULSA, OKLAHOMA
Character of Well (completed as Oil, Gas or Dry Hole) DRY HOLE
Date well completed 6-7 19 64
Application for plugging filed (PHONE 6-6-64) 6-15 19 64
Application for plugging approved (PHONE 6-6-64) 6-6 19 64
Plugging commenced 6-7 19 64
Plugging completed 6-7 19 64
Reason for abandonment of well or producing formation

NORTH

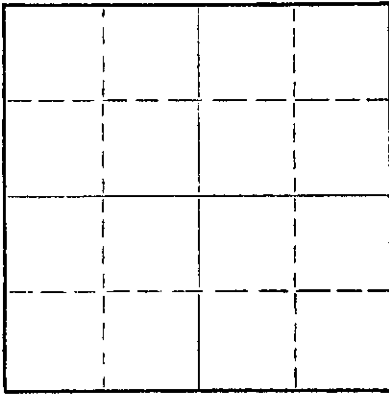

Locate well correctly on above
Section Plat

If a producing well is abandoned, date of last production 19
Was permission obtained from the Conservation Division or its agents before plugging was commenced? YES

Name of Conservation Agent who supervised plugging of this well HOWARD HESS, WINFIELD, KANSAS
Producing formation Depth to top Bottom Total Depth of Well 4363 Feet
Show depth and thickness of all water, oil and gas formations.

OIL, GAS OR WATER RECORDS

CASING RECORD

FORMATION	CONTENT	FROM	TO	SIZE	PUT IN	PULLED OUT
				8-5/8	235'	NONE

Describe in detail the manner in which the well was plugged, indicating where the mud fluid was placed and the method or methods used in introducing it into the hole. If cement or other plugs were used, state the character of same and depth placed, from feet to feet for each plug set.

FILLED HOLE WITH HEAVY MUD TO 245 FEET. SET FIRST PLUG @ 245' w/ 15 SACKS CEMENT AND 1/4 SACK HULLS. FILLED HOLE WITH HEAVY MUD TO 40 FEET. SET SECOND PLUG @ 40' WITH 8 SACKS CEMENT AND 1/4 SACK HULLS. FILLED RAT HOLE WITH 2 SACKS OF CEMENT AND MOUSE HOLE WITH 2 SACKS CEMENT.

RECEIVED
STATE CORPORATION COMMISSION

JUN 17 1964

CONSERVATION DIVISION
Wichita, Kansas

(If additional description is necessary, use BACK of this sheet)
Name of Plugging Contractor GABBERT-JONES INC.
Address 514 ORPHEUM BLDG., WICHITA, KANSAS

STATE OF KANSAS, COUNTY OF SEDGWICK, ss.
E. E. HALL (employee of owner) or (owner or operator) of the above-described well, being first duly sworn on oath, says: That I have knowledge of the facts, statements, and matters herein contained and the log of the above-described well as filed and that the same are true and correct. So help me God.

(Signature) [Signature]
514 ORPHEUM BLDG., WICHITA, KANSAS (Address)

SUBSCRIBED AND SWORN TO before me this 15TH day of JUNE 1964

My commission expires OCTOBER 2, 1967
VIRA A. MCKENZIE Notary Public.

GABBERT-JONES INC.
WICHITA, KANSAS
DRILLERS WELL LOG

9

H. G. ALTMAN #1
C SW SW SECTION 13-32S-4W
SUMNER COUNTY, KANSAS

COMMENCED: MAY 19, 1964
COMPLETED: JUNE 7, 1964

OPERATOR - VANDEVER PETROLEUM COMPANY

DEPTH		FORMATION	REMARKS
FROM	TO		
0	233	SURFACE SAND	RAN 235' 8-5/8" CASING, SET @ 235' W/ 150 SACKS CEMENT
233	600	CLAY	
600	615	ANHYDRITE	
615	1205	SHALE & SHELLS	
1205	3085	LIME & SHALE	
3085	3146	SHALE & SHELLS	
3146	3518	LIME	
3518	3770	LIME & SHALE	
3770	3910	LIME	
3910	3973	LIME CHERT	
3973	4016	LIME	
4016	4062	LIME CHERT	
4062	4278	LIME	
4278	4358	LIME & SHALE	
4358	4363	LIME	
4363	TD		

RECEIVED
STATE CORPORATION COMMISSION

JUN 17 1964

CONSERVATION DIVISION
Wichita, Kansas

DRY & ABANDONED

I, E. E. HALL, CERTIFY THIS IS A CORRECT COPY OF THE DRILLER'S LOG FOR THE WELL DRILLED IN C SW SW SECTION 13-32S-4W, SUMNER COUNTY, KANSAS, TO THE BEST OF MY KNOWLEDGE AND BELIEF.

E. E. Hall
E. E. HALL

STATE OF KANSAS)
) SS
COUNTY OF SEDGWICK)

BEFORE ME, THE UNDERSIGNED, A NOTARY PUBLIC WITHIN AND FOR SAID COUNTY AND STATE ON THIS 16TH DAY OF JUNE, 1964, PERSONALLY APPEARED E. E. HALL TO ME PERSONALLY KNOWN TO BE THE IDENTICAL PERSON WHO EXECUTED THE WITHIN AND FOREGOING INSTRUMENT AND ACKNOWLEDGED TO ME THAT HE EXECUTED THE SAME AS HIS FREE AND VOLUNTARY ACT AND DEED FOR THE USES AND PURPOSES THEREIN SET FORTH.

IN WITNESS WHEREOF, I HAVE HEREUNTO SET MY HAND AND OFFICIAL SEAL THE DAY AND YEAR LAST ABOVE WRITTEN.

Vira A. McKenzie
VIRA A. MCKENZIE, NOTARY PUBLIC

MY COMMISSION EXPIRES OCTOBER 2, 1967