


15-077-20279-0000

STATE OF KANSAS
STATE CORPORATION COMMISSION

Form CP-4

WELL PLUGGING RECORD

Give All Information Completely
Make Required Affidavit
Mail or Deliver Report to:
Conservation Division
State Corporation Commission
P. O. Box 17027
Wichita, Kansas 67217
NORTH

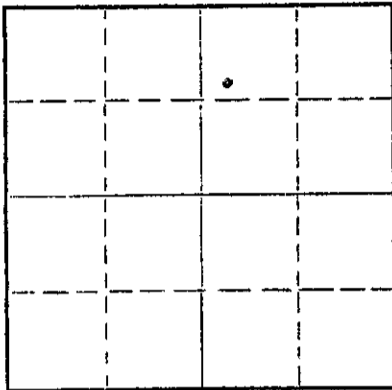

Locate well correctly on above
Section Plat

Harper County, Sec. 1 Twp. 31 Rge. (E) 8 (W)
Location as "NE/CNWKSWK" or footage from lines SW NW NE
Lease Owner Pickrell Drilling Company
Lease Name Wolf "D" Well No. 1
Office Address 205 Litwin Bldg., 110 N. Market, Wichita, Kansas 67202
Character of Well (completed as Oil, Gas or Dry Hole) oil
Date well completed 19
Application for plugging filed Nov. 17 1976
Application for plugging approved 19
Plugging commenced Nov. 20 1976
Plugging completed Nov. 23 1976
Reason for abandonment of well or producing formation depleted

If a producing well is abandoned, date of last production 19
Was permission obtained from the Conservation Division or its agents before plugging was commenced? YES

Name of Conservation Agent who supervised plugging of this well G. R. Biberstein
Producing formation _____ Depth to top _____ Bottom _____ Total Depth of Well 4479 Feet
Show depth and thickness of all water, oil and gas formations.

OIL, GAS OR WATER RECORDS

CASING RECORD

FORMATION	CONTENT	FROM	TO	SIZE	PUT IN	PULLED OUT
			210'	8 5/8"	210'	none
			4478'	4 1/2"	4478'	3910.66

Describe in detail the manner in which the well was plugged, indicating where the mud fluid was placed and the method or methods used in introducing it into the hole. If cement or other plugs were used, state the character of same and depth placed, from _____ feet to _____ feet for each plug set.

Sanded back to 4350' and dumped 4 sacks of cement.

Set 10' rock bridge at 220' and plugged well with 4 sacks of ready mix cement.

12-2-76

(If additional description is necessary, use BACK of this sheet)
Name of Plugging Contractor PIPE PULLERS, INC.
Address Box 128, Ellinwood, Kansas 67526

STATE OF KANSAS, COUNTY OF BARTON, ss.
Evelyn Roth (employee of owner) or (owner or operator) of the above-described well, being first duly sworn on oath, says: That I have knowledge of the facts, statements, and matters herein contained and the log of the above-described well as filed and that the same are true and correct. So help me God.

(Signature) Evelyn Roth
Ellinwood, Kansas (Address)

SUBSCRIBED AND SWORN to before me this 30th day of November, 1976

My commission expires

JENNY KASSELMAN
NOTARY PUBLIC
BARTON COUNTY, KANSAS
MY COMM. EXP. JULY 16, 1978

Jenny Kasselmann
Notary Public.

R TARY DRILLING LO

15-077-20279-0000

COMPANY: PICKRELL DRILLING COMPANY
705 FOURTH NAT'L BANK BLDG.

Rotary Drilling Commenced 9-10-74

WICHITA, KS. 67202

Rotary Drilling Completed 9-22-74

LOCATION: WOLF "D" #1
SW NW NE Sec. 1-31-8W
Harper County, Kansas

CONTRACTOR: PICKRELL DRILLING COMPANY
Wichita, Kansas

CASING RECORD: (5 joints) 8 5/8 surface casing set at 207' and cemented with 175 sacks cement. Job completed 9-10-74.
4 1/2" set at 4478 with 125 sack common cement.

LOG

(Figures indicate bottom of formation — measurements from top of rotary bushing.)

55	Top Soil	4055	Shale & Lime
85	Sand	4120	Lime
100	Shale	4200	Lime & Shale
600	Shale	4285	Shale & Lime
1540	Shale	4340	Lime & Shale
1750	Lime	4391	Lime & Shale
1940	Lime	4404	Miss. Chert
1965	Lime & Shale	4419	Miss.
2400	Lime & Shale	4455	Miss.
2665	Shale & Lime	4539	Chert. & Shale & Lime
2875	Shale & Lime	4565	Lime
3060	Shale & Lime	4615	Lime & Shale
3290	Lime & Shale	4715	Lime & Shale
3420	Lime & Shale	4765	Shale & Lime
3555	Shale & Lime-Sand	4772	Lime
3626	Shale	4789	Sand & Shale
3685	Shale & Lime		
3779	Lime		
3880	Lime		
3890	Lime		
3955	Lime & Shale		
4010	Lime & Shale		

11-17-76

The undersigned, C.W. SEBITS, Attorney-in-Fact for PICKRELL DRILLING COMPANY, hereby certifies in behalf of said Company, that the above is a true and correct log of the formation encountered in drilling the above well as reflected by the Daily Drilling Reports.

PICKRELL DRILLING COMPANY
By [Signature]
C.W. Sebitts Attorney-in-Fact

STATE OF KANSAS }
COUNTY OF SEDGWICK } ss.:

On this 27 day of January, 19 75, before me the undersigned, a Notary Public, in and for

the County and State aforesaid, personally appeared C. W. Sebitts, to me known to be the identical person who subscribed the name of PICKRELL DRILLING COMPANY to the foregoing instrument as its Attorney-in-Fact and acknowledged to me that he executed the same as his free and voluntary act and deed, and as the free and voluntary act and deed of such company, for the uses and purposes therein set forth.

Given under my hand and seal of office the day and year last above written.

My commission expires: August 19, 1975

[Signature]
Helen L. Martin Notary Public