

STATE OF KANSAS
STATE CORPORATION COMMISSION

WELL PLUGGING RECORD

Give All Information Completely
Make Required Affidavit
Mail or Deliver Report to:
Conservation Division
State Corporation Commission
212 No. Market
Wichita, Kansas

Harper County, Sec. 1 Twp. 31 Rge. 8 (E) W (W)
Location as "NE/CNWSW" or footage from lines NW NW NW
Lease Owner Champlin Petroleum Co.
Lease Name J. C. McIntyre Well No. 1
Office Address Box 308 Ellinwood, Ks.
Character of Well (completed as Oil, Gas or Dry Hole) Gas
Date well completed May 14 19 55
Application for plugging filed April 18 19 68
Application for plugging approved April 22 19 68
Plugging commenced July 11 19 68
Plugging completed July 13 19 68
Reason for abandonment of well or producing formation
No longer a commercial producer
If a producing well is abandoned, date of last production May 15 19 68
Was permission obtained from the Conservation Division or its agents before plugging was commenced? yes

NORTH

#			

Locate well correctly on above
Section Plat

Name of Conservation Agent who supervised plugging of this well Ralph Warren
Producing formation _____ Depth to top _____ Bottom _____ Total Depth of Well _____ Feet
Show depth and thickness of all water, oil and gas formations.

OIL, GAS OR WATER RECORDS

CASING RECORD

FORMATION	CONTENT	FROM	TO	SIZE	PUT IN	PULLED OUT
				8 5/8	316'	none
				5 1/2	4404'	3600'

Describe in detail the manner in which the well was plugged, indicating where the mud fluid was placed and the method or methods used in introducing it into the hole. If cement or other plugs were used, state the character of same and depth placed, from _____ feet to _____ feet for each plug set.

Plugged back with sand from 4393' to 3930'. Mixed and dumped 5 sx cement from 3930' to 3890'. Pulled casing. Mudded hole to 250'. Set 10' rock bridge from 250' to 240'. Mixed and dumped 25 sx cement from 240' to 165'. Mudded hole from 165' to 40'. Set 10' rock bridge from 40' to 30'. Mixed and dumped 10 sx cement from 30' to base of the cellar.

RECEIVED
STATE CORPORATION COMMISSION
JUL 19 1968
CONSERVATION DIVISION
Wichita, Kansas

(If additional description is necessary, use BACK of this sheet)


Name of Plugging Contractor Russ Casing Pulling Inc.
Address Box 1082 Great Bend, Kansas

STATE OF Kansas COUNTY OF Barton, ss.
Russell Hoberich (employee of owner) or (owner or operator) of the above-described well, being first duly sworn on oath, says: That I have knowledge of the facts, statements, and matters herein contained and the log of the above-described well as filed and that the same are true and correct. So help me God.

(Signature) Russell Hoberich
Box 1082 Great Bend, Ks. (Address)

18th day of JULY 1968

David H. Schawe
Notary Public.

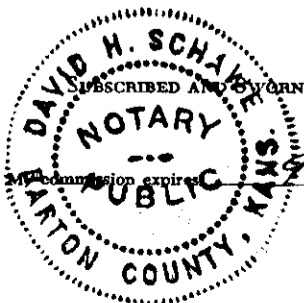

MC INTYRE #1WELL RECORD

LOCATION: NW/4 NW/4 NW/4 Sec. 1-31S-8W, Harper County, Kansas Commenced: 4-25-55
Completed: 5-10-55

OPERATOR: Champlin Oil & Refining Co.
Box 167
Ellinwood, Kansas

EASING RECORD: 8-5/8" 28#, 8Vthrd. L.W. @ 316 w/175 sx. cement
5-1/2" 14#, 8R thrd. J-S Spang @ 4044 w/150 sx. cement
2-3/8" 4.7#, 8R thrd. J-S Nat'l. @4369.97 w/

LOG:

Red bed sand	0	320
Red bed shale	320	530
Blue shale	530	1030
Shale - Anhydrite	1030	1525
Lime	1525	1744
Lime - Anhydrite	1744	1830
Lime	1830	1954
Lime - shale	1954	2924
Sandy lime	2924	3065
Shale - lime	3065	3387
Sand - lime	3387	3502
Lime - shale	3502	3622
Lime	3622	4407

FORMATION TOPS:

Douglas	3434	(-1781)
Lansing	3634	(-1981)
Kansas City	3878	(-2225)
Mississippi	4378	(-2725)
Total Depth	4405	(-2752)

I hereby certify that this is a true and correct log of the above described well as shown by the drilling reports.

CHAMPLIN OIL & REFINING CO.

By: J. W. Meyers
J. W. Meyers

STATE OF KANSAS)
) SS
COUNTY OF BALTON)

Subscribed and sworn to before me, a notary public, in and for said County and State this 2nd day of April, 1959.

W. Kenneth Oliver
Notary Public

My Commission expires 5-22-62

RECEIVED
STATE CORPORATION COMMISSION
APR 19 1968
CONSERVATION DIVISION
Wichita, Kansas