


STATE OF KANSAS
STATE CORPORATION COMMISSION
CONSERVATION DIVISION
P. O. BOX 17027
WICHITA, KANSAS 67217

WELL PLUGGING RECORD

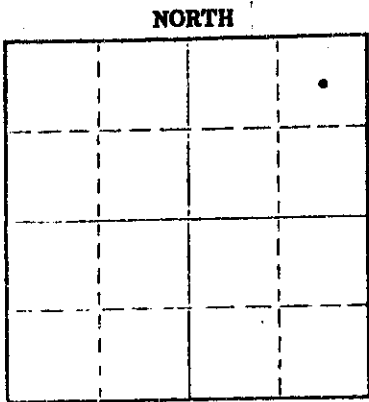

Locate well correctly on above
Section Plot

Harper County, Sec. 36 Twp. 31 Rge. (E) 7 (W)
Location as "NE/CNW/SE/SW" or footage from lines C NE NE
Lease Owner Aladdin Petroleum Corporation
Lease Name Seyb-Williams Well No. 1
Office Address 809 Petroleum Building, Wichita, Kansas 67202
Character of Well (completed as Oil, Gas or Dry Hole) oil
Date well completed 19____
Application for plugging filed 19____
Application for plugging approved 19____
Plugging commenced July 8 1975
Plugging completed July 18 1975
Reason for abandonment of well or producing formation depleted
If a producing well is abandoned, date of last production 19____
Was permission obtained from the Conservation Division or its agents before plugging was commenced? yes

Name of Conservation Agent who supervised plugging of this well G. R. Biberstein
Producing formation _____ Depth to top _____ Bottom _____ Total Depth of Well 4755 Feet
Show depth and thickness of all water, oil and gas formations.

OIL, GAS OR WATER RECORDS

CASING RECORD

FORMATION	CONTENT	FROM	TO	SIZE	PUT IN	PULLED OUT
			214'	8 5/8"	214'	none
			4751'	5 1/2"	4751'	4131.08

Describe in detail the manner in which the well was plugged, indicating where the mud fluid was placed and the method or methods used in introducing it into the hole. If cement or other plugs were used, state the character of same and depth placed, from _____ feet to _____ feet for each plug set.

Sanded back to 4300' and dumped 5 sacks of cement.
Set rock bridge at 200' and plugged well with 3 yards of ready mix cement.

RECEIVED
STATE CORPORATION COMMISSION
7-31-75
JUL 31 1975

(If additional description is necessary, use BACK of this sheet)
Name of Plugging Contractor PIPE PULLERS, INC.
Address Box 128, Ellinwood, Kansas 67526
CONSERVATION DIVISION
Wichita, Kansas

STATE OF KANSAS COUNTY OF BARTON ss.
Evelyn Roth (employee of owner) or (owner or operator) of the above-described well, being first duly sworn on oath, says: That I have knowledge of the facts, statements, and matters herein contained and the log of the above-described well as filed and that the same are true and correct. So help me God.

(Signature) Evelyn Roth
Ellinwood, Kansas (Address)

Subscribed and sworn to before me this 30th day of July 1975

My commission expires

JENNY CASSELMAN
NOTARY PUBLIC
BARTON COUNTY, KANSAS
MY COMM. EXP. JULY 16, 1978

Jenny Casselman
Notary Public

SEYB #1

LOCATION:	C NE/4 NE/4 Section 36-31S-7W Harper County, Kansas	DATE SPUDDED: 5-14-62
OPERATOR:	Walters Drilling Co.	ROTARY COMPLETION: 5-26-62
CONTRACTOR:	Walters Drilling Co.	ELEVATION: 1426 GL 1428 DF 1431 KB
SURFACE CASING:	8-5/8" @ 214' with 180 sacks cement	
OIL SPRING:	None	

L O G
(Figures indicate bottom of formation)

Sand & Red Bed	0-45'
Red Bed	215'
Shale, Shells & Red Bed	460'
Shale & Shells	1195'
Shale & Lime	1420'
Lime	1840'
Lime & Shale	2999'
Sand & Shale	3037'
Shale & Lime	3445'
Shale	3635'
Shale & Lime	3755'
Lime	3975'
Shale & Lime	4378'
Lime & Chert	4555'
Lime & Shale	4610'
Shale	4687'
Sand	4715'
Total Depth	4715'

JUL 2 1975
7-2-75

The undersigned, Robert F. Walters, hereby certifies that the above log is a true and correct log of the formations encountered in drilling the above noted well as reflected by the Daily Drilling Reports.

WALTERS DRILLING CO.

By
ROBERT F. WALTERS, Partner

Subscribed and sworn to before me
this 31st day of May, 1962

R. L. Abel, Notary Public

My commission expires January 4th, 1964

WASHDOWN JOB:

8-31-66 Garvey Drilling Co. moved in and set 5-1/2" @ 4754'.
9-1 & 2-66 Welex perforated 4689-4692.
9-22-66 Pumped 55 BO & 34 BW in 24 hrs.
Top of Wilcox 4689, Effective TD 4758'.