


15-077-01008-0000

STATE OF KANSAS  
STATE CORPORATION COMMISSION

Give All Information Completely  
Make Required Affidavit  
Mail or Deliver Report to:  
Conservation Division  
State Corporation Commission  
211 No. Broadway  
Wichita, Kansas

WELL PLUGGING RECORD

NORTH

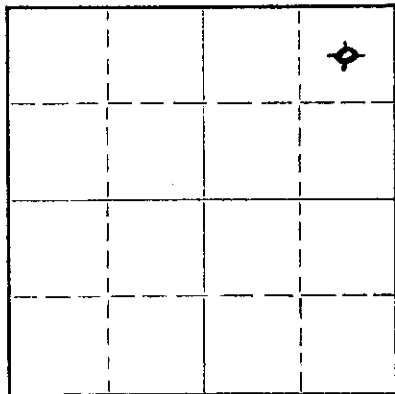

Locate well correctly on above  
Section Plat

HARPER County, Sec. 36 Twp. 31S Rge. 7 (E) W (W)

Location as "NE/CNW/SW" or footage from lines C NE/4 NE/4

Lease Owner Walters Drilling Co.

Lease Name Seyb Well No. 1

Office Address 510 Orpheum Building, Wichita 2, Kansas

Character of Well (completed as Oil, Gas or Dry Hole) Dry Hole

Date well completed May 26th 19 62

Application for plugging filed May 26th 19 62

Application for plugging approved May 26th 19 62

Plugging commenced May 26th 19 62

Plugging completed May 26th 19 62

Reason for abandonment of well or producing formation

If a producing well is abandoned, date of last production 19

Was permission obtained from the Conservation Division or its agents before plugging was commenced? Yes, Verbal approval from Corporation Commission

Name of Conservation Agent who supervised plugging of this well Fred Hampel

Producing formation Simpson Sand Depth to top Bottom Total Depth of Well 4715 Feet

Show depth and thickness of all water, oil and gas formations.

OIL, GAS OR WATER RECORDS

CASING RECORD

FORMATION	CONTENT	FROM	TO	SIZE	PUT IN	PULLED OUT
				8-5/8"	214'	-0-

Describe in detail the manner in which the well was plugged, indicating where the mud fluid was placed and the method or methods used in introducing it into the hole. If cement or other plugs were used, state the character of same and depth placed, from feet to feet for each plug set.

Set bottom plug @ 200' with 20 sacks cement,  
Set top plug @ 35' with 10 sacks cement.  
Job complete @ 10:00 AM

RECEIVED  
STATE CORPORATION COMMISSION  
JUN 4 1962  
6-4-62  
CONSERVATION DIVISION  
Wichita, Kansas

(If additional description is necessary, use BACK of this sheet)

Name of Plugging Contractor Walters Drilling Co.

Address 510 Orpheum Building, Wichita 2, Kansas

STATE OF KANSAS, COUNTY OF SEDGWICK, ss.

Robert F. Walters

(owner or operator) of the above-described well, being first duly sworn on oath, says: That I have knowledge of the facts, statements, and matters herein contained and the log of the above-described well as filed and that the same are true and correct. So help me God.

(Signature) Robert F. Walters  
ROBERT F. WALTERS, Partner  
510 Orpheum Building, Wichita 2, Kansas  
(Address)

SUBSCRIBED AND SWORN TO before me this 31st day of May, 19 62

R. L. Abel  
R. L. Abel  
Notary Public.

My commission expires January 4th, 1964



SEYB #1

LOCATION: C NE/4 NE/4 Section 36-31S-7W DATE SPUDDED: 5-14-62  
 Harper County, Kansas

OPERATOR: Walters Drilling Co. ROTARY COMPLETION: 5-26-62

CONTRACTOR: Walters Drilling Co. ELEVATION: 1426 GL  
 1428 DF  
 1431 KB

SURFACE CASING: 8-5/8" @ 214' with 180 sacks cement

OIL SPRING: None


L O G  
 (Figures indicate bottom of formation)

Sand & Red Bed	0-45'
Red Bed	215'
Shale, Shells & Red Bed	460'
Shale & Shells	1195'
Shale & Lime	1420'
Lime	1840'
Lime & Shale	2999'
Sand & Shale	3037'
Shale & Lime	3445'
Shale	3635'
Shale & Lime	3755'
Lime	3975'
Shale & Lime	4378'
Lime & Chert	4555'
Lime & Shale	4610'
Shale	4687'
Sand	4715'
Total Depth	4715'

**RECEIVED**  
 STATE CORPORATION COMMISSION  
 JUN 4 1962  
 6-4-62  
 CONSERVATION DIVISION  
 Wichita, Kansas

The undersigned, Robert F. Walters, hereby certifies that the above log is a true and correct log of the formations encountered in drilling the above noted well as reflected by the Daily Drilling Reports.

WALTERS DRILLING CO.

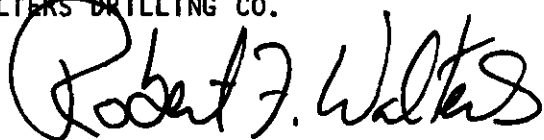By   
 ROBERT F. WALTERS, Partner

Subscribed and sworn to before me  
 this 31st day of May, 1962

  
 R. L. Abel, Notary Public

My commission expires January 4th, 1964