


15-077-00088-0000

STATE OF KANSAS
STATE CORPORATION COMMISSION

Give All Information Completely
Make Required Affidavit
Mail or Deliver Report to:
Conservation Division
State Corporation Commission
311 No. Broadway
Wichita, Kansas

WELL PLUGGING RECORD

Harper County, Sec. 36 Twp. 31S Rge. 7W (E) (W)
Location as "NE/CNW%SW%" or footage from lines C SE NE
Lease Owner Walters Drilling Co.
Lease Name Seyb Well No. 1
Office Address Wichita, Kansas
Character of Well (completed as Oil, Gas or Dry Hole) Dry Hole
Date well completed 7/18/61 19
Application for plugging filed 7/22/61 19
Application for plugging approved 7/25/61 19
Plugging commenced 7/22/61 19
Plugging completed 7/25/61 19
Reason for abandonment of well or producing formation _____

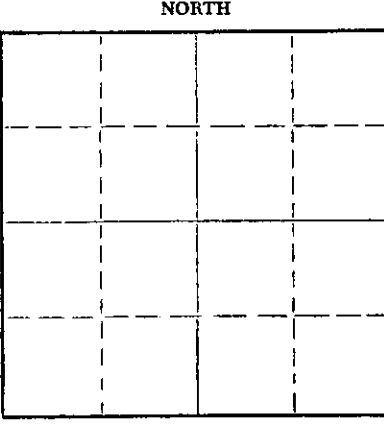

Locate well correctly on above
Section Plat

If a producing well is abandoned, date of last production _____ 19____
Was permission obtained from the Conservation Division or its agents before plugging was commenced? Verbal approval obtained from Fred W. Hampel 7/22/61

Name of Conservation Agent who supervised plugging of this well Fred W. Hampel
Producing formation _____ Depth to top _____ Bottom _____ Total Depth of Well _____ Feet
Show depth and thickness of all water, oil and gas formations.

OIL, GAS OR WATER RECORDS

CASING RECORD

FORMATION	CONTENT	FROM	TO	SIZE	PUT IN	PULLED OUT
				8 5/8"	204.61'	-0-
				4 1/2"	4,714.34'	3,175.11'

Describe in detail the manner in which the well was plugged, indicating where the mud fluid was placed and the method or methods used in introducing it into the hole. If cement or other plugs were used, state the character of same and depth placed, from _____ feet to _____ feet for each plug set.

Plugged bottom back to 4650 ft. with sand dumped 4 sacks cement with bailer. Set rock bridge at 200 ft. put in 20 sacks cement. Filled with mud to 35 ft. put in 10 sacks cement on top.

RECEIVED
STATE CORPORATION COMMISSION
AUG 10 1961
8-10-61
CONSERVATION DIVISION
Wichita, Kansas

(If additional description is necessary, use BACK of this sheet)

Name of Plugging Contractor Central Pipe Pulling Co.
Address 1416 Coolidge, Great Bend, Kansas

STATE OF KANSAS, COUNTY OF SEDGWICK, ss.
Robert F. Walters ~~Comptroller of Kansas~~ (owner or operator) of the above-described well, being first duly sworn on oath, says: That I have knowledge of the facts, statements and matters herein contained and the log of the above-described well as filed and that the same are true and correct. So help me God.
(Signature) Robert F. Walters
Robert F. Walters
510 Orpheum Building, Wichita, Kansas
(Address)

SUBSCRIBED AND SWORN TO before me this 8th day of August, 19 61

My commission expires January 4, 1964

R. L. Abel
R. L. Abel
Notary Public.



15-077-00088-0000
R

SEYB #1

LOCATION: C SE/4 NE/4 Sec. 36-31S-7W DATE SPUDDED: June 26, 1961
 Harper County, Kansas ROTARY COMPLETION: July 10, 1961

OPERATOR: Arvel C. Smith, ELEVATION: 1418 GL
 Benedict Oil Assoc., etal 1421 DF

CONTRACTOR: Walters Drilling Co. 1423 KB

SURFACE CASING: 8-5/8" set at 210' with
 175 sacks cement

OIL STRING: 4-1/2" set at 4710' with
 200 sacks cement

L O G
(Figures indicate bottom of formation)

Sand	0-50'
Shale	210'
Shale & Shells	300'
Rock & Shale	600'
Shale & Shells	1155'
Lime & Shale	2550'
Shale	2690'
Lime & Shale	3002'
Sand & Shale	3027'
Shale & Lime	3780'
Lime	3868'
Lime & Shale	3882'
Lime	3944'
Lime & Shale	4324'
Lime	4390'
Lime & Chert	4550'
Shale & Lime	4618'
Sand	4711'
Total Depth	4711'

RECEIVED
 STATE CORPORATE COMMISSION
 AUG 22 1961
 8-22-61
 CONSERVATION DIVISION
 Wichita, Kansas

The undersigned, Robert F. Walters, hereby certifies that the above log is a true and correct log of the formations encountered in drilling the above noted well as reflected by the Daily Drilling Reports.

WALTERS DRILLING CO.

by Robert F. Walters
 ROBERT F. WALTERS, Partner

Subscribed and sworn to before me
this 17th day of July, 1961

R. L. Abel
 R. L. ABEL, Notary Public

My commission expires January 4, 1964