


WELL PLUGGING RECORD

Give All Information Completely
Make Required Affidavit
Mail or Deliver Report to:
Conservation Division
State Corporation Commission
212 North Market, Insurance Bldg.
Wichita, Kansas

NORTH

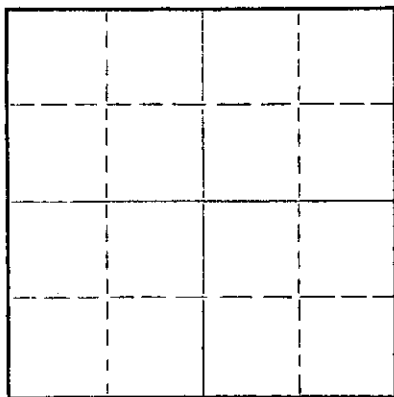

Locate well correctly on above
Section Plat

County. Sec. 11 Twp. 33 Rge. 3 (X) W (W)
Location as "NE/CNW/SW" or footage from lines NE/SE SW
Lease Owner Leben Drilling, Inc. & NCRA
Lease Name Armstrong Well No. 2
Office Address 905 Central Bldg. Wichita 2, Kansas
Character of Well (completed as Oil, Gas or Dry Hole) Dry Hole
Date well completed 1-10-1961 19
Application for plugging filed 1-10-1961 19
Application for plugging approved 1-10-1961 19
Plugging commenced 1-10-1961 19
Plugging completed 1-10-1961 19
Reason for abandonment of well or producing formation Dry Hole

If a producing well is abandoned, date of last production _____ 19____
Was permission obtained from the Conservation Division or its agents before plugging was commenced? Yes

Name of Conservation Agent who supervised plugging of this well Fred W. Hampel
Producing formation _____ Depth to top _____ Bottom _____ Total Depth of Well 4433 Feet
Show depth and thickness of all water, oil and gas formations.

OIL, GAS OR WATER RECORDS

CASING RECORD

FORMATION	CONTENT	FROM	TO	SIZE	PUT IN	PULLED OUT
				8-5/8"	212'	

Describe in detail the manner in which the well was plugged, indicating where the mud fluid was placed and the method or methods used in introducing it into the hole. If cement or other plugs were used, state the character of same and depth placed, from _____ feet to _____ feet for each plug set.

1st plug set @ 210' w/ 15 sx. cement & 1/2 sx. hulls
2nd plug set @ 40' w/ 10 sx. cement & 1/2 sx. hulls

(If additional description is necessary, use BACK of this sheet)

Name of Plugging Contractor Leben Drilling, Inc.
Address 905 Central Building Wichita 2, Kansas

STATE OF KANSAS, COUNTY OF SEDGWICK, ss.
Frank Hamlin (employee of owner) or (owner or operator) of the above-described well, being first duly sworn on oath, says: That I have knowledge of the facts, statements, and matters herein contained and the log of the above-described well as filed and that the same are true and correct. So help me God.

(Signature) Frank Hamlin
Frank Hamlin
905 Central Bldg. Wichita 2, Kansas
(Address)

SUBSCRIBED AND SWORN TO before me this 13th day of January, 19 61

Bette J. Behymer
Bette J. Behymer Notary Public.

My commission expires July 27, 1964



RECEIVED
STATE CORPORATION COMMISSION

JAN 24 1961

CONSERVATION DIVISION

DRILLER'S LOG

COMPANY: **LEBEN DRILLING, INC.**
CONTRACTOR: **LEBEN DRILLING, INC.**
FARM: **ARMSTRONG #2**
LOCATION: **C NE SW SEC. 11-335-3W**
SUMNER COUNTY, KANSAS
COMMENCED: **12-21-60**
COMPLETED: **1-10-61**

0	40	Surface Sand & Redbed
40	212	Shale & Shells
212	420	Shale & Lime
420	695	Shale & Shells
695	1015	Shale & Lime
1015	1155	Shale & Lime
1155	1925	Shale & Lime
1925	2220	Shale & Lime
2220	2335	Shale & Lime
2335	2460	Shale
2460	3065	Shale & Lime
3065	3320	Shale & Lime
3320	3430	Lime
3430	3580	Lime
3580	3712	Lime
3712	3930	Lime
3930	3973	Lime
3973	4095	Chert & Lime
4095	4130	Chert & Lime
4130	4170	Chert
4170	4205	Chert & Lime
4205	4240	Mississippi
4240	4322	Mississippi
4322	4370	Lime
4370	4410	Lime & Shale
4410	4433	Lime
	<u>4433</u>	<u>Rotary Total Depth - D & A</u>

Set 8 5/8" surface casing @ 212' with 200 sacks Sunset cement.

I, Frank Hamlin, do hereby certify that the above and foregoing is a true and correct copy of the log of the Armstrong #2, located C NE SW of Section 11, Township 33 South, Range 3 West, Sumner County, Kansas, as reflected by the files of Leben Drilling, Inc.

Frank Hamlin

Frank Hamlin

STATE OF KANSAS)
COUNTY OF SEDGWICK) SS

Subscribed and sworn to before me, a Notary Public, in and for Sedgwick County, Kansas, this 20th day of January, 1961.

Bette J. Behymer

Bette J. Behymer, Notary Public

My Commission Expires:
July 27, 1964

RECEIVED
STATE CORPORATION COMMISSION

JAN 24 1961

CONSERVATION DIVISION
Wichita, Kansas