


STATE OF KANSAS  
STATE CORPORATION COMMISSION

WELL PLUGGING RECORD

Give All Information Completely  
Make Required Affidavit  
Mail or Deliver Report to  
Conservation Division  
State Corporation Comm.  
245 North Water  
Wichita, KS 67202

County. Sec. 27 Twp. 33 Rge. 3 N/W  
Location as "NE/CNW $\frac{1}{4}$ /SW $\frac{1}{4}$ " or footage from lines  
NW NE NE

Lease Owner Dean Allison Oil Co.  
Lease Name Gracy Well No. 1  
Office Address 507 Insurance Bldg., Wichita, Ks. 67202  
Character of Well (Completed as Oil, Gas or Dry Hole) dry hole

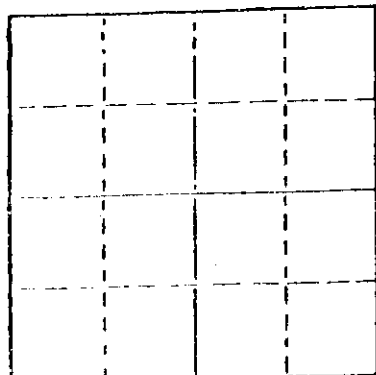

Locate well correctly on above  
Section Plat

Date Well completed 8-9-77 1977  
Application for plugging filed 8-9 1977  
Application for plugging approved 8-9 1977  
Plugging commenced 8-9 1977  
Plugging completed 8-9 1977

Reason for abandonment of well or producing formation  
no commercial quantities of oil or gas encountered  
If a producing well is abandoned, date of last production  
-- 19

Was permission obtained from the Conservation Division or  
its agents before plugging was commenced? yes

Name of Conservation Agent who supervised plugging of this well Ted Dewey  
Producing formation \_\_\_\_\_ Depth to top \_\_\_\_\_ Bottom \_\_\_\_\_ Total Depth of Well 4530  
Show depth and thickness of all water, oil and gas formations.

OIL, GAS OR WATER RECORDS

CASING RECORD

FORMATION	CONTENT	FROM	TO	SIZE	PUT IN	PULLED OUT
surface hole	shale	surface	260	8-5/8"	257	none

Describe in detail the manner in which the well was plugged, indicating where the mud fluid was placed and the method or methods used in introducing it into the hold. If cement or other plugs were used, state the character of same and depth placed, from \_\_\_\_\_ feet to \_\_\_\_\_ feet for each plug set.

Fluid to 260, plug, 25 sx  
Fluid to 40, plug, 10 sx  
2 sx in rat hole

RECEIVED  
STATE CORPORATION COMMISSION

AUG 12 1977

CONSERVATION DIVISION  
Wichita, Kansas

(If additional description is necessary, use BACK of this sheet)

Name of Plugging Contractor D N B DRILLING, INC.  
515 R. H. Garvey Building  
Wichita, Kansas 67202

STATE OF Kansas COUNTY OF Sedgwick, ss.  
Ella Priess (employee of owner) or (owner or operator)  
of the above-described well, being first duly sworn on oath, says: That I have knowledge of the facts, statements, and matters herein contained and the log of the above-described well as filed and that the same are true and correct. So help me God.

(Signature)

Ella Priess

515 R.H. Garvey Bldg., Wichita, Ks. 67202  
(Address)

SUBSCRIBED AND SWORN TO before me this 11th day of August, 19 77

My commission expires April 30, 1979

Dorothy L. Schmidt  
Dorothy L. Schmidt Notary Public.

DOROTHY L. SCHMIDT  
STATE NOTARY PUBLIC  
Sedgwick County, Kansas  
My Appt. Exp. April 30, 1979

DRILLERS' LOG

DEAN ALLISON OIL CO.  
No. 1 Gracy  
NW NE NE Sec. 27-33S-3W  
Sumner Co., Kansas

Commenced: 7-29-77  
Completed: 8-9-77

Surface Casing: 257' of 8-5/8"  
cemented w/215 sx, 2% gel, 3% cc  
7-29-77

FORMATION

DEPTH

Surface Hole	0 - 260
Shale	260 - 572
Shale & Lime	572 - 1555
Lime & Shale	1555 - 1838
Shale & Lime	1838 - 2355
Lime & Shale	2355 - 3190
Shale & Lime	3190 - 3515
Lime & Shale	3515 - 3980
Lime	3980 - 4080
Lime & Shale	4080 - 4530 RTD
Lime	

I do hereby certify that the foregoing statements are true and correct to the best of my knowledge and belief.

D N B DRILLING, INC.

*Ella Priess*  
Ella Priess

STATE OF KANSAS: ss:

Subscribed and sworn to before me this 11th day of August, 1977.

*Dorothy L. Schmidt*  
Dorothy L. Schmidt, Notary Public

RECEIVED  
STATE CORPORATION COMMISSION  
AUG 12 1977

CONSERVATION DIVISION  
Wichita, Kansas

DOROTHY L. SCHMIDT  
STATE NOTARY PUBLIC  
Sedgwick County, Kansas  
My Appt. Exp. April 30, 1979