


15-191-21572-0000

WELL PLUGGING RECORD

Give All Information Completely
 Make Required Affidavit

COUNTY Sumner SEC. 11 TWP. 33S RGE. 2 ~~EAX~~
 Location as in quarters or footage from lines:
990' FSL 2310' FEL of SE ¼

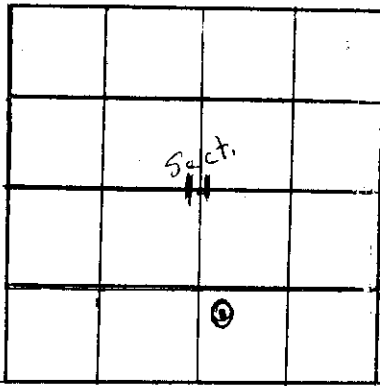

Locate Well
 correctly on above
 Section Platt.

Lease Owner Glacier Petroleum Company, Inc.
 Lease Name Merle Meils Well No. 1
 Office Address P.O. Box 577, Emporia, Kansas 66801
 Character of Well (Completed as Oil, Gas or Dry Hole): Dry Hole
 Date Well Completed 8-13-83
 Application for plugging filed yes
 Plugging commenced 8-13-83
 Plugging completed 8-13-83
 Reason for abandonment of well or producing formation Dry Hole

Was permission obtained from the Conservation Division or it's
 Agent's before plugging was commenced? yes

Name of Conservation Agent who supervised plugging of this well Glenn Ward

Producing formation _____ Depth to top _____ bottom _____ T.D. 4,277'

Show depth and thickness of all water, oil and gas formations.

OIL, GAS OR WATER RECORDS

Casing Record

Formation	Content	From	To	Size	Put in	Pulled Out
				8-5/8"	553'	

Describe in detail the manner in which the well was plugged, indicating where the mud fluid was placed and the method or methods used in introducing it into the hold. If cement or other plugs were used, state the character of same and depth placed, from _____ feet to _____ feet for each plug set.

Mud to 1250' hull plug, 35 sacks cement. Mud to 600' hull plug, 35 sacks cement.
 Mud to 60 feet, hull plug, 20 sacks cement.

RECEIVED
 STATE CORPORATION COMMISSION
 SEP 13 1983
 CONSERVATION DIVISION
 Wichita, Kansas

(If additional description is necessary, use BACK of this sheet)

Name of Plugging Contractor Glacier Drilling Company, Inc.


STATE OF Kansas COUNTY OF Lyon, ss.

Loren D. Martin (employee of owner) or (owner or operator) of the

above-described well, being first duly sworn on oath, says: That I have knowledge of the facts, statements, and matters herein contained and the log of the above-described well as filed and that the same are true and correct. So help me God.

(Signature) Loren D. Martin
1825 Commercial
Emporia, Kansas 66801
 (Address)

SUBSCRIBED AND SWORN TO before me this 10th day of SEPT., 1983

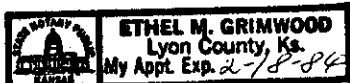

Ethel M. Grimwood
 Notary Public.

My Commission expires: _____