


STATE OF KANSAS
STATE CORPORATION COMMISSION

WELL PLUGGING RECORD

Give All Information Completely
Make Required Affidavit
Mail or Deliver Report to
Conservation Division
State Corporation Comm.,
245 North Water
Wichita, KS 67202

Harper County, Sec. 18 Twp. 31S Rge. 6W E/W
Location as "NE/CNW $\frac{1}{4}$ /SW $\frac{1}{4}$ " or footage from lines
C SW SW NE

Lease Owner Chief Drilling Co., Inc.
Lease Name King Well No. 1
Office Address 905 Century Plaza, Wichita, Kansas 67202
Character of Well (Completed as Oil, Gas or Dry Hole)
Dry Hole

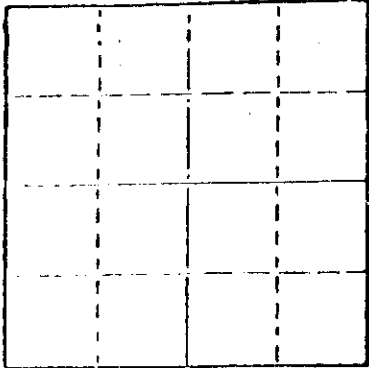

Locate well correctly on above
Section Plat

Date Well completed April 3 19 80
Application for plugging filed April 3 19 80
Application for plugging approved April 3 19 80
Plugging commenced April 3 19 80
Plugging completed April 3 19 80
Reason for abandonment of well or producing formation
Dry Hole

If a producing well is abandoned, date of last production
19

Was permission obtained from the Conservation Division or
its agents before plugging was commenced? yes

Name of Conservation Agent who supervised plugging of this well Carl Barnett
Producing formation Depth to top Bottom Total Depth of Well 4797
Show depth and thickness of all water, oil and gas formations.

OIL, GAS OR WATER RECORDS

CASING RECORD

FORMATION	CONTENT	FROM	TO	SIZE	PUT IN	PULLED OUT
				8 5/8"	311	-0-

Describe in detail the manner in which the well was plugged, indicating where the mud fluid
was placed and the method or methods used in introducing it into the hold. If cement or other
plugs were used, state the character of same and depth placed, from feet to
feet for each plug set.

Plugged with 35 sx cement @ 320',
Bridge & 10 sx cement @ 40',
3 sx cement in rathole.

(If additional description is necessary, use BACK of this sheet)

Name of Plugging Contractor B & B Drilling, Inc.

STATE OF KANSAS COUNTY OF SEDGWICK, ss.
Bill Lahar (employee of owner) or (owner or operator)

of the above-described well, being first duly sworn on oath, says: That I have knowledge of
the facts, statements, and matters herein contained and the log of the above-described well
as filed and that the same are true and correct. So help me God.

(Signature)

Bill Lahar

515 Union Center, Wichita, Kansas 67202
(Address)

SUBSCRIBED AND SWORN TO before me this 7th day of April, 19 80

Betty M. Abbott
Betty M. Abbott Notary Public.

My commission expires January 22, 1983



15-077-20578-0000

DRILLERS LOG

April 7, 1980

#1 King
C SW SW NE
Sec. 18-31S-6W
Harper County, Kansas

OPERATOR: Chief Drilling Co., Inc.
CONTRACTOR: B & B Drilling, Inc.
COMMENCED: March 19, 1980
COMPLETED: April 3, 1980

8 5/8" @ 311' w/250 sx

0	655	Shale & Shells
655	930	Shale
930	1720	Shale & Shells
1720	1820	Lime & Shale
1820	2015	Shale
2015	3847	Lime & Shale
3847	4084	Lime
4084	4270	Shale & Lime
4270	4333	Lime
4333	4386	Shale & Lime
4386	4797	Lime
4797		RTD D & A

We certify that the above and foregoing is a true and correct copy of the log on the #1 King located in Harper County, Kansas.

B & B DRILLING, INC.

Bill Lahar

Bill Lahar

President

Subscribed and sworn to before me this 7th day of April, 1980.

Betty M. Abbott

Betty M. Abbott

Notary Public

My Commission Expires:

January 22, 1983



4-7-80