


STATE OF KANSAS
STATE CORPORATION COMMISSION

WELL PLUGGING RECORD

Give All Information Completely
Make Required Affidavit
Mail or Deliver Report to
Conservation Division
State Corporation Comm.
245 North Water
Wichita, KS 67202

Harper County, Sec. 2 Twp. 31S Rge. 7 W
Location as "NE/CNW $\frac{1}{4}$ SW $\frac{1}{4}$ " or footage from lines
100' SE of NE-NE-NW
Lease Owner Eldon J. Schierling
Lease Name Williams Well No. 2
Office Address 830 Sutton Place, Wichita, Ks. 67202
Character of Well (Completed as Oil, Gas or Dry Hole)

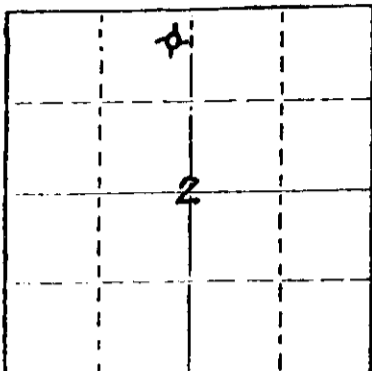

Locate well correctly on above
Section Plot

Dry Hole
Date Well completed April 20 1982
Application for plugging filed April 20 1982
Application for plugging approved April 20 1982
Plugging commenced April 20 1982
Plugging completed April 20 1982
Reason for abandonment of well or producing formation

D & A
If a producing well is abandoned, date of last production 19

Was permission obtained from the Conservation Division or its agents before plugging was commenced? Yes

Name of Conservation Agent who supervised plugging of this well Maurice Leslie
Producing formation - Depth to top Bottom Total Depth of Well 4397
Show depth and thickness of all water, oil and gas formations.

OIL, GAS OR WATER RECORDS

CASING RECORD

FORMATION	CONTENT	FROM	TO	SIZE	PUT IN	PULLED OUT

Describe in detail the manner in which the well was plugged, indicating where the mud fluid was placed and the method or methods used in introducing it into the hold. If cement or other plugs were used, state the character of same and depth placed, from feet to feet for each plug set.

Cement - 620' - 60 sacks
300' - 40 sacks
40' - 10 sacks
Rathole - 10 sacks

RECEIVED
STATE CORPORATION COMMISSION
6-4-82
JUN - 4 1982
CONSERVATION DIVISION
Wichita, Kansas

(If additional description is necessary, use BACK of CONSERVATION sheet)

Name of Plugging Contractor Allied Cementing Co., Inc.


STATE OF Kansas COUNTY OF Sedgwick, ss.
Eldon J. Schierling (employee of owner) or (owner or operator
of the above-described well, being first duly sworn on oath, says: That I have knowledge of the facts, statements, and matters herein contained and the log of the above-described well as filed and that the same are true and correct. So help me God.

(Signature) Eldon J. Schierling
830 Sutton Place, Wichita, Ks.
(Address)

SUBSCRIBED AND SWORN TO before me this 3rd day of June, 1982

Shirley A. Cramer
Notary Public.

My commission expires 9-29-84

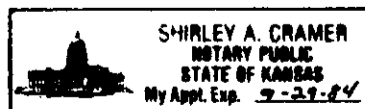

GABBERT-JONES, INC.
 WICHITA, KANSAS
 DRILLERS' WELL LOG

Williams #2
 100' SE of NE-NE-NW
 Sec 2-31S-7W
 Harper County Kansas

Commenced: 4-13-82

Completed: 4-20-82

OPERATOR: ELDON SCHIERLING

Depth		Formation	Remarks
From	To		
0	40	Sand	
40	2122	Shale-Shells	Ran 7 jts of 24# 8 5/8"
2122	2460	Shale-Lime Stks	set @ 304' Cemented w/
2460	2612	Shale-Lime	225 sks Common 3% CC
2612	4397	Lime-Shale	2% Gel PD @ 10:00 p.m.
	4397 - TD		4-13-82
			DRY & ABANDONED

STATE OF KANSAS)
) SS
 COUNTY OF SEDGWICK)

I, the undersigned, being duly sworn on oath, state that the above Drillers' Well Log is true and correct to the best of my knowledge and belief and according to the records of this office.

GABBERT-JONES, INC.

James S. Sutton II
 JAMES S. SUTTON II

Subscribed and sworn to before me this 22nd day of April, 1982.

Elizabeth J. Edwards
 ELIZABETH J. EDWARDS-NOTARY PUBLIC

My Commission expires February 6, 1983.

