

15-035-00747-0000


STATE OF KANSAS
STATE CORPORATION COMMISSION

WELL PLUGGING RECORD

Give All Information Completely
Make Required Affidavit
Mail or Deliver Report to:
Conservation Division
State Corporation Commission
800 Bitting Building
Wichita, Kansas

Cowley County, Sec. 35 Twp. 31 Rge. 7 (E) E (W)

Location as "NE/CNW%SW%" or footage from lines NW SW NE
Lease Owner Ayesh Oil Company
Lease Name Hough Well No. 1
Office Address 300 Orpheum Bldg, Wichita, Kansas
Character of Well (completed as Oil, Gas or Dry Hole) Dry Hole
Date well completed 3-21 1955
Application for plugging filed 19
Application for plugging approved 19
Plugging commenced 3-21 1955
Plugging completed 3-21 1955
Reason for abandonment of well or producing formation _____

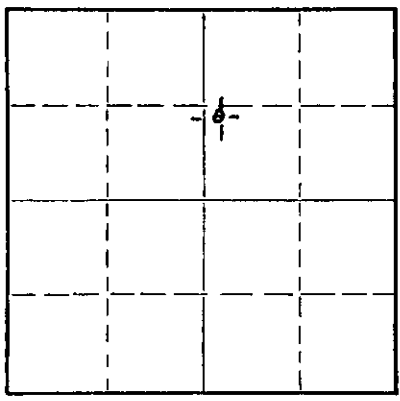

Locate well correctly on above
Section Plat

If a producing well is abandoned, date of last production 19
Was permission obtained from the Conservation Division or its agents before plugging was commenced? Yes.

Name of Conservation Agent who supervised plugging of this well W. L. Lemaster
Producing formation _____ Depth to top _____ Bottom _____ Total Depth of Well 3388 Feet
Show depth and thickness of all water, oil and gas formations.

OIL, GAS OR WATER RECORDS

CASING RECORD

FORMATION	CONTENT	FROM	TO	SIZE	PUT IN	PULLED OUT
				8-5/8"	110	

Describe in detail the manner in which the well was plugged, indicating where the mud fluid was placed and the method or methods used in introducing it into the hole. If cement or other plugs were used, state the character of same and depth placed, from _____ feet to _____ feet for each plug set.

T. D. 3338
Mud 3338 to 180'
Cement 180 to 140
Mud 140 to 35
Cement 35 to 0
Steel Plate welded on S.P.

(If additional description is necessary, use BACK of this sheet)

Name of Plugging Contractor McKnab & Lindsay Drilling Co.
Address 1117 Millington, Winfield, Kansas

STATE OF Kansas, COUNTY OF Sedgwick, ss.
Richard R. Ayesh, partner ~~(employee of owner)~~ or (owner or operator) of the above-described well, being first duly sworn on oath, says: That I have knowledge of the facts, statements, and matters herein contained and the log of the above-described well as filed and that the same are true and correct. So help me God.
(Signature) Richard R. Ayesh
AYESH OIL COMPANY
Partner
300 Orpheum Bldg., Wichita 2, Ks.
(Address)

SUBSCRIBED AND SWORN to before me this 30th day of March, 19 55

My commission expires September 10, 1958
Anna R. Walker
Notary Public.

PLUGGING
FILE SEC 35 T 31 R 7E
BOOK PAGE 106 LINE 22

03-31-55

WELL RECORD

HOUGH NO. 1

Owner. Ayesh Oil Co.
Contr. McKnab & Lindsay
Sec. NW SW NE 35-31-7E

Comm. 3-9-55
Comp. 3-21-55
County. Cowley County, Ks.

Drillers Log.

lime	0	110
shale & shells	110	159
shale & sand	159	445
shale, sand & lime	445	1025
shale sand & lime	1025	1360
sand & shale	1360	1650
shale	1650	1700
sand	1700	1770
shale & lime	1770	1890
shale & lime	1890	2087
sand & shale	2087	2177
shale & lime	2177	2213
shale & lime	2213	2234
lime	2234	2361
shale & lime	2361	2415
sandy shale	2415	2467
lime & shale	2467	2786
shale & lime	2786	2870
shale & lime	2870	2904
lime	2904	2942
lime	2942	2973
lime	2973	3031
lime	3031	3047
lime	3047	3070
lime	3070	3086
lime	3086	3104
lime	3104	3122
lime	3122	3145
lime	3145	3165
lime	3165	3181
lime	3181	3192
lime	3192	3214
lime	3214	3243
lime	3243	3270
lime	3270	3289
lime & shale	3289	3388
Total Depth		3388

Casing Record

110" - 8-5/8"
225 sacks cement

RECEIVED
STATE COMMISSION
MAR 31 1955
CONSERVATION DIVISION
Wichita, Kansas

PLUGGING
FILE SEC 35 T 51 R 7E
HOSE PAGE 100 LINK 22