


Give All Information Completely  
Make Required Affidavit  
Mail or Deliver Report to:  
Conservation Division  
State Corporation Commission  
212 North Market, Insurance Bldg.  
Wichita, Kansas

WELL PLUGGING RECORD

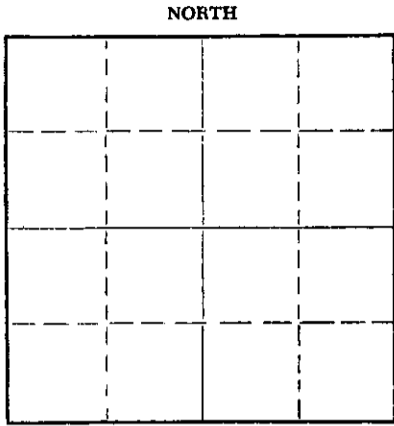

Locate well correctly on above Section Plat

Sumner County, Sec. 22 Twp. 31S Rge. 1 (E) 1 (W)  
Location as "NE/CNW/SE/SW" or footage from lines 330' E/L, 330' S/L SE/4  
Lease Owner Aladdin Petroleum Corporation  
Lease Name Heskett Well No. 1  
Office Address 809 Petroleum Building  
Character of Well (completed as Oil, Gas or Dry Hole) Oil  
Date well completed August 25, 1955  
Application for plugging filed Sept. 5, 1963  
Application for plugging approved Sept. 6, 1963  
Plugging commenced Sept. 15 1963  
Plugging completed Sept. 19 1963  
Reason for abandonment of well or producing formation not profitable

If a producing well is abandoned, date of last production September 1963  
Was permission obtained from the Conservation Division or its agents before plugging was commenced? yes

Name of Conservation Agent who supervised plugging of this well Howard Hess  
Producing formation \_\_\_\_\_ Depth to top \_\_\_\_\_ Bottom \_\_\_\_\_ Total Depth of Well 3715 Feet  
Show depth and thickness of all water, oil and gas formations.

OIL, GAS OR WATER RECORDS

CASING RECORD

FORMATION	CONTENT	FROM	TO	SIZE	PUT IN	PULLED OUT
				8-5/8	358'	None
				5-1/2	3715	2633'

Describe in detail the manner in which the well was plugged, indicating where the mud fluid was placed and the method or methods used in introducing it into the hole. If cement or other plugs were used, state the character of same and depth placed, from \_\_\_\_\_ feet to \_\_\_\_\_ feet for each plug set.

Plug 3 sacks cement @ 3130'.  
Mud to 320'  
Rock Bridge 320' to 300'  
Filled w/4 yards ready-mix cement from 300' to base of cellar.

**RECEIVED**  
STATE CORPORATION COMMISSION

OCT 8 1963

CONSERVATION DIVISION  
Wichita, Kansas

(If additional description is necessary, use BACK of this sheet)  
Name of Plugging Contractor Glenn & Smith Pipe Pulling Co.  
Address Box 156 Ellinwood, Kansas

STATE OF KANSAS, COUNTY OF SEDGWICK, ss.  
Jerome M. Johnson (employee of owner) ~~xxx xxx xxx xxx~~ of the above-described well, being first duly sworn on oath, says: That I have knowledge of the facts, statements, and matters herein contained and the log of the above-described well as filed and that the same are true and correct. So help me God.

(Signature) [Signature]  
J. M. Johnson 809 Petroleum Building  
(Address)

SUBSCRIBED AND SWORN TO before me this 1st day of October, 1963

My commission expires November 1, 1965 [Signature] Notary Public.

15-191-10039-0000

WELL LOG BUREAU—KANSAS GEOLOGICAL SOCIETY  
503 East Murdock  
Wichita, Kansas




*Aladdin Petr Co.*

Company- SKELLY OIL CO.  
Farm- J. O. Heskett No. 1

SEC. 22 T. 31 R. 1W  
SE SE SE  
330' fr EL, 330' fr SL, SE/4

Total Depth. 3715 PBD 3670  
Comm. 6-18-55 Comp. 7-1-55  
Shot or Treat Acid: 2250 gals. 3645-3656  
Contractor. Claude Wentworth Drilling Co., Inc.  
Issued. 10-15-55

County Sumner  
KANSAS

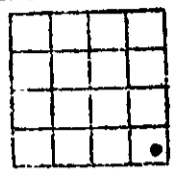

Elevation. 1266 DF

Production Pot. 27 BO, 1.68  
BWPD

CASING:

8 5/8 @ 358' w/ 225 sx cmt.  
5 1/2 @ 3715' w/ 150 sx cmt.


surface soil & shale	40
lime & shells	430
lime & shale	2410
lime	2450
shale & shells	2575
shale & sand	2765
shale	2822
lime & shale	3098
lime	3212
lime & shale	3272
lime	3354
lime & shale	3644
cherty dolomite	3664
shaley lime	3704
cherty lime	3715
Total Depth	PB 3670

TOPS:

Stalnaker	2640	1374
Kansas City	2992	1726
Base K. C.	3230	1964
Marmaton lime	3326	2060
Mississippi dolomite	3644	2378

**RECEIVED**  
STATE CORPORATION COMMISSION

OCT 29 1963

CONSERVATION DIVISION  
Wichita, Kansas

DST #1: packer 3644' 20' anchor, open  
1 hr. good blow thruout, rec. 1800'  
gas, 75' HOCM, IFP Q#, FFP 70#, BHP  
510#/20 min.

Ran Schlumberger Survey

Producing Formation: Mississippi lime  
3649 1/2 - 3658

Perf. 3645-56 w/66 holes bailed 1 hr, 10 GG + 2 gal murky str  
Perf. 3649 1/2 - 58 w/48 holes

- Shot w/250 gals 3645-56 7-8-55
- Shot w/500 " 3645-56 7-9-55
- Shot w/1500 " 3645-3656 7-10-55
- Acid 2000 gals 3645-56 7-12-55
- Hydrafrac 3645-56
- Acid 500 gals 3649 1/2 - 58 8-15-55
- Acid 1000 " 3649 1/2 - 58 8-16-55

Significant Show oil 3645-58