

CARD MUST BE TYPED

State of Kansas
NOTICE OF INTENTION TO DRILL
(see rules on reverse side)

CARD MUST BE SIGNED

Starting Date:12-3-85.....
month day year 3/42

API Number 15- 077-21,120-0000

OPERATOR: License #6033.....

C N/2 NE NW Sec 22 Twp 31 S, Rge 6
(location) East West

NameMurfin Drilling Company.....

Address250 N. Water, Suite 300.....

City/State/ZipWichita, Ks. 67202.....

Contact PersonDavid Doyel.....

Phone316-267-3241.....

4950 Ft North from Southeast Corner of Section

3300 Ft West from Southeast Corner of Section

(Note: Locate well on Section Plat on reverse side)

CONTRACTOR: License #6033.....

NameMurfin Drilling Company.....

City/StateWichita, Ks. 67202.....

Nearest lease or unit boundary line330..... feet.

County Harper.....

Lease Name Hufford..... Well# 1-22.....

Domestic well within 330 feet: yes no

Municipal well within one mile: yes no

Well Drilled For: Well Class: Type Equipment:

Oil Swd Infield Mud Rotary

Gas Inj Pool Ext. Air Rotary

OWWO Expl Wildcat Cable

Depth to Bottom of fresh water100!..... feet

Lowest usable water formation-----.....

Depth to Bottom of usable water250!..... feet

Surface pipe by Alternate: 1 2

Surface pipe to be set300!..... feet

Conductor pipe if any required-----..... feet

Ground surface elevation1422..... feet MSI.

This Authorization Expires6-3-86.....

Approved By12-3-85.....

If OWWO: old well info as follows:

Operator

Well Name

Comp Date Old Total Depth

Projected Total Depth4700..... feet

Projected Formation at TDSimpson.....

Expected Producing FormationsSimpson.....

I certify that we will comply with K.S.A. 55-101, et seq., plus eventually plugging hole to K.C.C. specifications.

Date .12/3/85..... Signature of Operator or AgentDavid Doyel..... TitleGeologist.....


Must be filed with the K.C.C. five (5) days prior to commencing well
This card void if drilling not started within six (6) months of date received by K.C.C.

RECEIVED
STATE CORPORATION COMMISSION

12-3-85
DEC 03 1985

A Regular Section of Land
1 Mile = 5,280 Ft.

CONSERVATION DIVISION
WICHITA, KANSAS

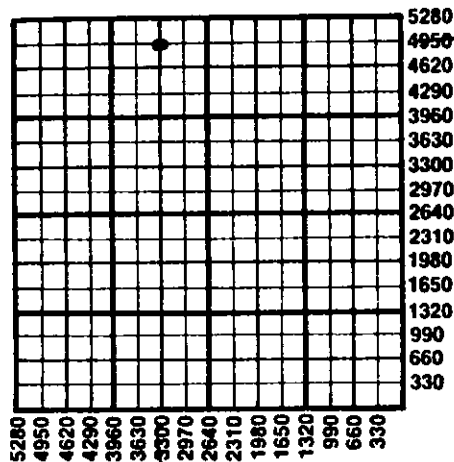

Important procedures to follow:

1. Notify District office before setting surface casing.
2. Set surface casing by circulating cement to the top.
3. File completion forms ACO-1 with K.C.C. within 90 days of well completion, following instructions on ACO-1, side 1, and including copies of wireline logs.
4. Notify District office 48 hours prior to old well workover or re-entry.
5. Prior to plugging, prepare a plugging plan, then obtain agreement from the appropriate district office for an approved plugging plan.
6. Submit plugging report (CP-4) to K.C.C. after plugging is completed.
7. Obtain an approved injection docket number before disposing of salt water.
8. Notify K.C.C. within 10 days when injection commences or terminates.
9. If an alternate 2 completion, cement in the production pipe from below any usable water to surface within 120 days of spud date.

State Corporation Commission of Kansas
Conservation Division
200 Colorado Derby Building
Wichita, Kansas 67202
(316) 263-3238