

CARD MUST BE TYPED

State of Kansas  
**NOTICE OF INTENTION TO DRILL**  
(see rules on reverse side)

CARD MUST BE SIGNED

Starting Date: August 15, 1985  
month day year

API Number 15- 077-21,099-0000

OPERATOR: License # 9869  
Name Chapman Energy Oklahoma, Inc.  
Address 120 S. Market, Suite 320  
City/State/Zip Wichita, KS 67202  
Contact Person David N. Cargo  
Phone 316-262-1191

E/2 NE NW Sec 11 Twp 31 S, Rge 6  
(location) 4620 Ft North from Southeast Corner of Section  
2970 Ft West from Southeast Corner of Section  
(Note: Locate well on Section Plat on reverse side)

CONTRACTOR: License # 5420  
Name White & Ellis Drilling, Inc.  
City/State Wichita, KS 67202

Nearest lease or unit boundary line 330 feet.  
County Harper  
Lease Name Joslin Well# I-11

Well Drilled For: Well Class: Type Equipment:  
 Oil  Swd  Infield  Mud Rotary  
 Gas  Inj  Pool Ext.  Air Rotary  
 OWWO  Expl  Wildcat  Cable

Domestic well within 330 feet:  yes  no  
Municipal well within one mile:  yes  no

If OWWO: old well info as follows:

Operator .....  
Well Name .....  
Comp Date ..... Old Total Depth .....  
Projected Total Depth 4350 feet  
Projected Formation at TD Mississippian  
Expected Producing Formations Mississippian

Depth to Bottom of fresh water 200~60 feet  
Lowest usable water formation .....  
Depth to Bottom of usable water 200 feet  
Surface pipe by Alternate: 1  2   
Surface pipe to be set 380 feet  
Conductor pipe if any required N/A feet  
Ground surface elevation 1381 feet MSI.  
This Authorization Expires 1-26-86  
Approved By RCH 7-26-85

I certify that we will comply with K.S.A. 55-101, et seq., plus eventually plugging hole to K.C.C. specifications.

Date July 26, 1985 Signature of Operator or Agent David N. Cargo Title Geologist

Must be filed with the K.C.C. five (5) days prior to commencing well  
This card void if drilling not started within six (6) months of date received by K.C.C.

RECEIVED  
STATE CORPORATION COMMISSION


7-26-85  
JUL 26 1985

Important procedures to follow:

A Regular Section of Land  
1 Mile = 5,280 Ft.

CONSERVATION DIVISION  
Wichita, Kansas

1. Notify District office before setting surface casing.
2. Set surface casing by circulating cement to the top.
3. File completion forms ACO-1 with K.C.C. within 90 days of well completion, following instructions on ACO-1, side 1, and including copies of wireline logs.
4. Notify District office 48 hours prior to old well workover or re-entry.
5. Prior to plugging, prepare a plugging plan, then obtain agreement from the appropriate district office for an approved plugging plan.
6. Submit plugging report (CP-4) to K.C.C. after plugging is completed.
7. Obtain an approved injection docket number before disposing of salt water.
8. Notify K.C.C. within 10 days when injection commences or terminates.
9. If an alternate 2 completion, cement in the production pipe from below any usable water to surface within 120 days of spud date.

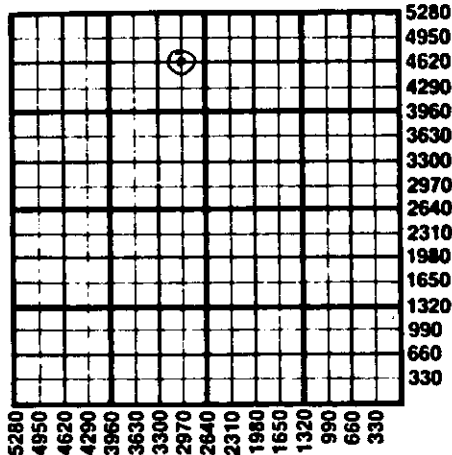

State Corporation Commission of Kansas  
Conservation Division  
200 Colorado Derby Building  
Wichita, Kansas 67202  
(316) 263-3238