

NOTICE OF INTENTION TO DRILL

(see rules on reverse side)

Starting Date OCT 9 1986 month day year

API Number 15- 077-21,142-0000

OPERATOR: License # 5842 Name Gabbert-Jones, Inc. Address 333 East English City/State/Zip Wichita, Ks. 67202 Contact Person J. W. Gabbert Phone 316-263-6209

NW SW NW Sec. 31 Twp. 31 S, Rg. 6 East West 3630 4750 Ft. from South Line of Section Ft. from East Line of Section

(Note: Locate well on Section Plat on reverse side)

CONTRACTOR: License # 5842 Name Gabbert-Jones, Inc. City/State Wichita, Ks.

Nearest lease or unit boundary line 330 feet

County Harper

Lease Name K. V. Williams Well # 1

Ground surface elevation feet MSL

Well Drilled For: Well Class: Type Equipment: X Oil SWD Infield Mud Rotary X Gas Inj Pool Ext Air Rotary OWWO Expl Wildcat Cable

Domestic well within 330 feet: yes X no

Municipal well within one mile: X yes no

Surface pipe by Alternate: 1 X 2

If OWWO: old well info as follows:

Depth to bottom of fresh water 125

Depth to bottom of usable water 200

Surface pipe planned to be set 280

Projected Total Depth 4750 feet

Formation Simpson

Operator Well Name Comp Date Old Total Depth

I certify that well will comply with K.S.A. 55-101, et seq., plus eventually plugging hole to KCC specifications.

cementing will be done immediately upon setting production casing.

Date 10-9-86 Signature of Operator or Agent Title

For KCC Use:

Conductor Pipe Required feet; Minimum Surface Pipe Required 200 feet per Alt.


This Authorization Expires 4-9-87 Approved By 10-9-86

Must be filed with the K.C.C. five (5) days prior to commencing well
This card void if drilling not started within six (6) months of date received by K.C.C.

Important procedures to follow:

1. Notify District office before setting surface casing.
2. Set surface casing by circulating cement to the top.
3. File completion forms ACO-1 with K.C.C. within 90 days of well completion, following instructions on ACO-1, side 1, and including copies of wireline logs.
4. Notify District office 48 hours prior to old well workover or re-entry.
5. Prior to filing Intent, prepare a proposed plugging plan in case well is D & A, then obtain approval of plan when calling district office prior to setting surface pipe.
6. Submit plugging report (CP-4) to K.C.C. after plugging is completed.
7. Obtain an approved injection docket number before disposing of salt water.
8. Notify K.C.C. within 10 days when injection commences or terminates.

A Regular Section of Land 1 Mile = 5,280 Ft.

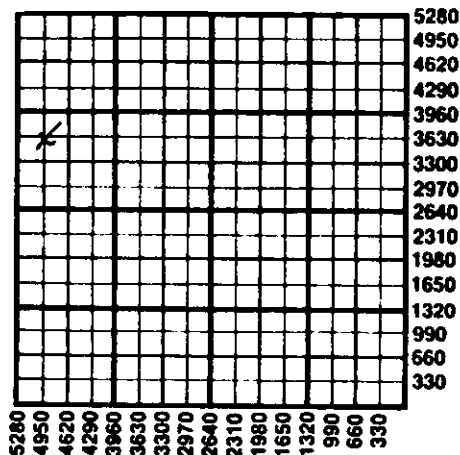

RECEIVED
STATE CORPORATION COMMISSION

OCT 10-9-86
CONSERVATION DIVISION
Wichita, Kansas

an alternate 2 completion, cement in the production pipe from
below any usable water to surface within 120 days of spud date.

State Corporation Commission of Kansas
Conservation Division
200 Colorado Derby Building
Wichita, Kansas 67202
(316) 263-3238