


15-077-21358-0000
BAKER SERVICE TOOLS - TALLY PAD

New Completion Workover

Oil Company _____ Well No. ~~1~~ 1 Field _____ Lease Miles "D"
Company Man _____ Date Drilled July, 1998 County Harper State Kansas

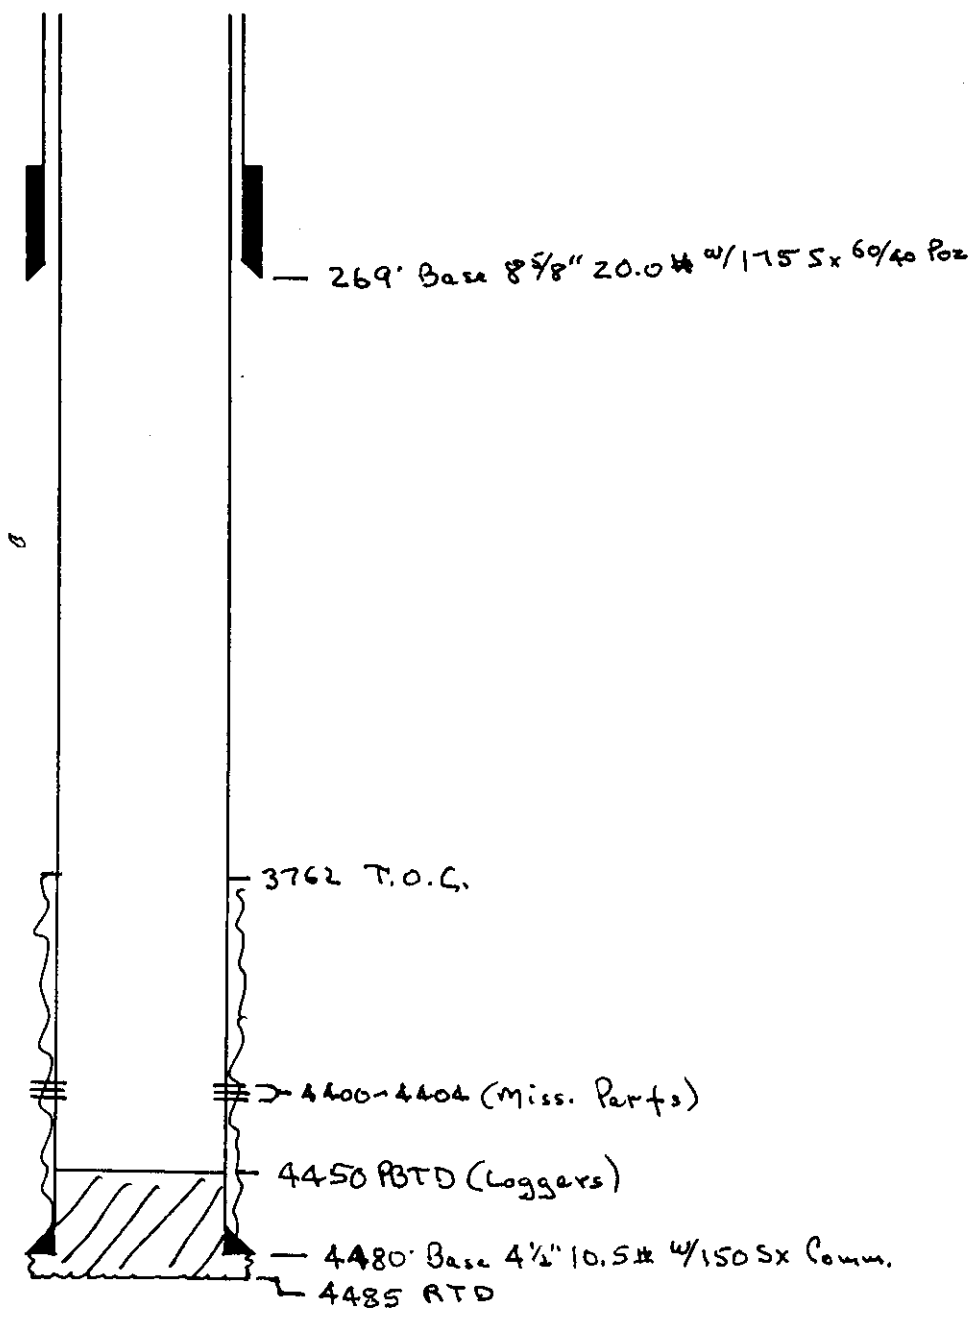

RECEIVED
OIL AND GAS COMMISSION
DEC - 8 1998
REGISTRATION DIVISION
Wichita, Kansas

REMARKS: _____



Kansas Corporation Commission

Bill Graves, Governor John Wine, Chair Susan M. Seltsam, Commissioner Cynthia L. Claus, Commissioner

NOTICE OF RECEIPT OF WELL PLUGGING APPLICATION (CP-1)

December 9, 1998

Pickrell Drilling Company, Inc.
110 N. Market, Suite 205
Wichita, Ks. 67202

Miles D #1
API 15-00721358 - 0000
SE SE SW
Sec. 12-31S-8W
Harper County

Dear Ron Smith,

This letter is to notify you that the Conservation Division is in receipt of your plugging proposal, form CP-1, for the above-captioned well.

Your CP-1 has been reviewed by the Conservation Division central office for completeness and to verify license numbers. The plugging proposal will now be forwarded to the district office listed below for review of your proposed method of plugging.

Please contact the district office for approval of your proposed plugging method at least at five (5) days before plugging the well, pursuant to K.A.R. 82-3-113 (b). If a workover pit will be used during the plugging of the well it must be permitted. A CDP-1 form must be filed and approved prior to the use of the pit.

The Conservation Division's review of form CP-1, either in the central or district office, does not include an inquiry into well ownership or the filing operator's legal right to plug the well.

This notice in no way constitutes authorization to plug the above-captioned well by persons not having legal rights of ownership or interest in the well. This notice is void after ninety (90) days from the above date.

Sincerely,

David P. Williams
Production Supervisor

District: #2
130 S. Market Room 2125
Wichita KS 67202-3208
(316) 337-6231