


STATE OF KANSAS  
STATE CORPORATION COMMISSION

Form CP-4

Give All Information Completely  
Make Required Affidavit  
Mail or Deliver Report to:  
Conservation Division  
State Corporation Commission  
212 No. Market  
Wichita, Kansas 67202

WELL PLUGGING RECORD

NORTH

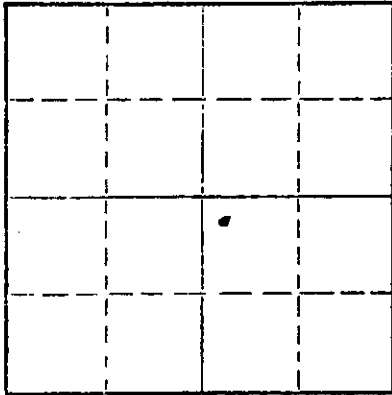

Locate well correctly on above  
Section Plat

Sumner County, Sec. 8 Twp. 35 Rge. (E) 2 (W)  
Location as "NE/CNWSW" or footage from lines C NW NW SE  
Lease Owner Kingery Drilling Co., Inc.  
Lease Name Smock Well No. 1  
Office Address Box 1588, Ardmore, Okla. 73401  
Character of Well (completed as Oil, Gas or Dry Hole) Dry Hole  
Date well completed 3-18-72 19  
Application for plugging filed 3-18-72 19  
Application for plugging approved 3-18-72 19  
Plugging commenced 3-18-72 19  
Plugging completed 3-18-72 19  
Reason for abandonment of well or producing formation Dry Hole

If a producing well is abandoned, date of last production 19  
Was permission obtained from the Conservation Division or its agents before plugging was commenced? Yes

Name of Conservation Agent who supervised plugging of this well Eugene Graham  
Producing formation Depth to top Bottom Total Depth of Well 4820 Feet  
Show depth and thickness of all water, oil and gas formations.

OIL, GAS OR WATER RECORDS

CASING RECORD

FORMATION	CONTENT	FROM	TO	SIZE	PUT IN	PULLED OUT
				8-5/8	210'	

Describe in detail the manner in which the well was plugged, indicating where the mud fluid was placed and the method or methods used in introducing it into the hole. If cement or other plugs were used, state the character of same and depth placed, from feet to feet for each plug set.

Plug set @ 210' with 30 sacks  
Plug set @ 40' with 10 sacks  
Bridged Rat Hole with 2 sacks

Gabbert & Jones - Drilling Contractor  
Supervised by their Mr. Bob Wynn.

RCW  
03-20-72

(If additional description is necessary, use BACK of this sheet)

Name of Plugging Contractor Halliburton  
Address

STATE OF Oklahoma, COUNTY OF Carter, ss.  
Harold H. Holden (employee of owner) of the above described well, being first duly sworn on oath, says: That I have knowledge of the facts, statements, and matters herein contained and the log of the above-described well as filed and that the same are true and correct. So help me God.

(Signature) Harold H. Holden  
Box 1588, Ardmore, Oklahoma 73401  
(Address)

SUBSCRIBED AND SWORN TO before me this 21st day of March, 1972

Doyle Davis

My commission expires August 7, 1972

Notary Public.