

WELL PLUGGING RECORD

Give All Information Completely
Make Required Affidavit
Mail or Deliver Report to:
Conservation Division
State Corporation Commission
500 Bittling Building
Wichita, Kansas

Sumner County. Sec. 4 Twp. 35 Rge. (E) 2 (W)

Location as "NE/CNW/SW" or footage from lines SE. SE. SE.

Lease Owner Champlin Refining Co.

Lease Name Stephens Well No. 1

Office Address Enid, Oklahoma

Character of Well (completed as Oil, Gas or Dry Hole) Dry hole.

Date well completed 4/3/50

Application for plugging filed ~~same~~ April 22, 1950

Application for plugging approved Same

Plugging commenced May 9, 1950

Plugging completed May 15, 1950

Reason for abandonment of well or producing formation No production, dry.

If a producing well is abandoned, date of last production No production

Was permission obtained from the Conservation Division or its agents before plugging was commenced? Yes

Name of Conservation Agent who supervised plugging of this well W. G. Buffington

Producing formation Depth to top Bottom Total Depth of Well 4757' Feet

Show depth and thickness of all water, oil and gas formations.

OIL, GAS OR WATER RECORDS

CASING RECORD

Formation	Content	From	To	Size	Put In	Pulled Out
				10-3/4"	835'	None
				7" OD	4757'	1400'

Describe in detail the manner in which the well was plugged, indicating where the mud fluid was placed and the method or methods used in introducing it into the hole. If cement or other plugs were used, state the character of same and depth placed, from feet to feet for each plug set.

Hole was cemented at the bottom with 25 sacks cement. Hole was pumped full of rotary mud up and into surface csg and kept full or rotary mud while casing was being pulled.

Hole was plugged back from 4757' to 4680'. Casing was shot 16 times before pipe was finally started. Shots were at 4000', 3900', 3800', 3700', 3600', 3200', 3000', 2900', 2800', 2500', 2400', 2200', 1900', 1800', 1600', 1400' pipe finally shot off at 1400' and 1400' of 7" OD casing pulled.

A test by Halliburton was used to determine if the salt sand area below surface pipewould take water which it did at practically no pressure.

Pumped 45 sacks Drey cement to bottom of surface pipe. Then dumped 5 Sacks cement in top of surface pipe.

RECEIVED
JUN 2 X 1950
STATE CORPORATION COMMISSION
KANSAS
06-02-50

(If additional description is necessary, use BACK of this sheet)

Correspondence regarding this well should be addressed to Champlin Refining Company
Address Enid, Oklahoma

STATE OF Oklahoma, COUNTY OF Garfield, ss.
W. W. Oberlander (employee of owner) or (owner or operator) of the above-described well,

being first duly sworn on oath, says: That I have knowledge of the facts, statements, and matters herein contained and the log of the above-described well as filed and that the same are true and correct. So help me God.


(Signature) W. W. Oberlander
Box 552
(Address)

SUBSCRIBED AND SWORN to before me this 31 day of May, 19 50

My commission expires May 19, 1951

Peggy Gober
Notary Public.

FILE SEC 25 R 27
BOOK PAGE 2 LINE 27

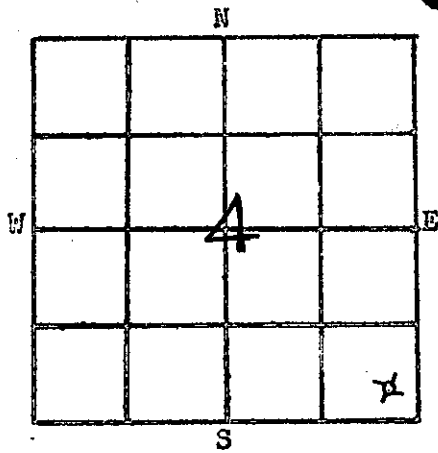

WELL RECORD

COUNTY Sumner SEC. 4 TWP. 35 S RGE. 2 W
 COMPANY OPERATING Champlin Refining Company
 OFFICE ADDRESS Box 552, Enid, Oklahoma
 FARM NAME Stephens "A" WELL NO. 1
 WELL LOCATED 330' from East Line
330' from South Line
 CHARACTER OF WELL Dry Hole

Drilling Commenced Nov. 8, 1949

Drilling Completed Dec. 28, 1949

CASING RECORD

SIZE	WEIGHT	THDS.	MAKE	FT.	IN.	AMOUNT PULLED	CEMENT
10 3/4" OD	40#	8 Thd.	Used	829	0	None	500 Sacks
7" OD	23#	8 Rd.	National	4757	0	None	100 Sacks

FORMATION RECORD

	TOP	BOTTOM		TOP	BOTTOM
Shale, gravel & shells	0	580	Lime and chert	4290	4310
Shale, shells, salt & anhydrite	580	670	Lime	4310	4490
Anhydrite, gyp & shale	670	810	Broken Lime	4490	4505
Lime and sand	810	867	Lime	4505	4640
Shale and anhydrite	867	898	Lime and chert	4640	4655
Shale and shells	898	985	Lime and shale	4655	4720
Shale and sandy lime	985	1100	Lime and sand	4720	4727
Shale and lime	1100	1630	Sand (Cored)	4727	4757
Shale and sandy lime	1630	1800			
Shale and lime	1800	2270			
Lime	2270	2340			
Lime and sand streaks	2340	2530			
Lime and shale	2530	2640			
Lime, sand and shale	2640	2795			
Lime and shale	2795	3045			
Lime, shale and sand	3045	3160			
Sand and shale	3160	3340			
Shale and lime	3340	3410			
Shale, lime shells & sand	3410	3475			
Shale and sandy lime	3475	3715			
Shale and lime	3715	3755			
Sandy lime and shale	3755	3830			
Lime	3830	4005			
Shale and lime	4005	4075			
Shale	4075	4205			
Shale & sand streaks	4205	4245			
Shale	4245	4267			
Chat	4267	4273			
Lime (Cored)	4273	4290			

RECEIVED
 JUN 19 1950
 ST. C. SECTION
 OKLAHOMA

J. C. Montworth
 Superintendent

Subscribed and sworn to before me
 this 9th day of January, 1950

Peggy Guber
 Notary Public

My Commission expires May 19, 1951

PLUGGING
 FILE SEC 4 T 35 R 2
 BOOK PAGE 2 LINE 7