

STATE OF KANSAS  
STATE CORPORATION COMMISSION

WELL PLUGGING RECORD

Give All Information Completely  
Make Required Affidavit  
Mail or Deliver Report to:  
Conservation Division  
State Corporation Commission  
800 Bitting Building  
Wichita, Kansas

OR


FORMATION PLUGGING RECORD

Strike out upper line  
when reporting plug-  
ging of formations.

SUMNER County. Sec. 23 Twp. 33S Rge. (E) 3 (W)

Location as "NE $\frac{1}{4}$ NW $\frac{1}{4}$ SW $\frac{1}{4}$ " or footage from lines. ~~XXXXX~~ NE NE SW  
Lease Owner. THE BAY PETROLEUM CORPORATION  
Lease Name. DENNETT Well No. 1  
Office Address. 1006 Brown Building, Wichita 2, Kansas  
Character of Well (completed as Oil, Gas or Dry Hole) dry hole  
Date well completed. 10/15/44 19  
Application for plugging filed. 10/15/44 19  
Application for plugging approved. 10/15/44 19  
Plugging commenced. 10/15/44 19  
Plugging completed. 10/15/44 19  
Reason for abandonment of well or producing formation. dry hole

NORTH

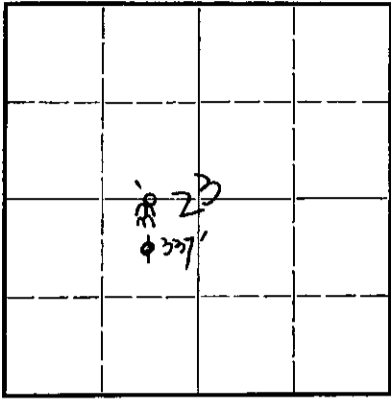

Locate well correctly on above  
Section Flat

If a producing well is abandoned, date of last production. 19  
Was permission obtained from the Conservation Division or its agents before plugging was com-  
menced? yes

Name of Conservation Agent who supervised plugging of this well. Mr. W. L. Lemaster  
Producing formation. Depth to top. Bottom. Total Depth of Well. Feet

Show depth and thickness of all water, oil and gas formations.

OIL, GAS OR WATER RECORDS


CASING RECORD

Formation	Content	From	To	Size	Put In	Pulled Out
Surface pipe		1	667	8-5/8"	667	none

Describe in detail the manner in which the well was plugged, indicating where the mud fluid was placed and the method or methods used in introducing it into the hold. If cement or other plugs were used, state the character of same and depth placed, from \_\_\_\_\_ feet to \_\_\_\_\_ feet for each plug set.

Set wood plug at 250' and run 15 sacks of cement. Filled hole with heavy mud to bottom of cellar and welded steel plate on top of surface pipe in bottom of cellar.

23 33 3W  
195 20

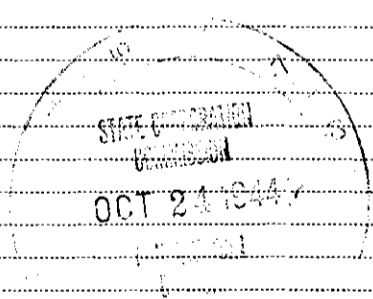

(If additional description is necessary, use BACK of this sheet)

Correspondence regarding this well should be addressed to THE BAY PETROLEUM CORPORATION, 1006 Brown Building, Wichita 2, Kansas

STATE OF KANSAS, COUNTY OF SEDGWICK, ss.  
I, Clair A. Foster (employee of owner) or (owner/producer) of the above-described well,

being first duly sworn on oath, says: That I have knowledge of the facts, statements, and matters herein contained and the log of the above-described well as filed and that the same are true and correct. So help me God.

(Signature) Clair A. Foster  
c/o THE BAY PETROLEUM CORPORATION  
1006 Brown Building, Wichita 2.

SUBSCRIBED AND SWORN to before me this 23rd day of October, 1944

Mary [Signature] Notary Public.


My commission expires November 2, 1946

Company - BAY PETRO. CORP. ET AL  
 Farm - Dennett No. 1.

SEC. 23 T. 33 R. 3 W  
 NE SW

Total Depth. 4565' (4563 DF)  
 Comm. 9-8-44 Comp. 10-15-44  
 Shot or Treated.  
 Contractor. R.C. Patton Co.  
 Issued. 11-4-44

County. Sumner  
 KANSAS

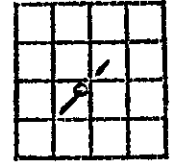

CASING:  
 8 5/8" 667' Cem.

Elevation. 1738

Production. Dry

Figures indicate Bottom of Formations.

red bed & sand	65	lime & shale	4480
shale & red rock	120	shale	4500
shale & shells	540	shale & sand	4517
lime	545	sand	4565
shale	560	Total Depth.	
anhydrite & shale	730		(DF 4563)
anhydrite	820	Tops:	
shale sdy	905	Ft. Riley Limestone	968
shale & lime	1080	Iatan? Limestone	3020
shale gy	1170	Stalnaker Sandstone	3060
shale & lime	1200	K.C. Limestone (samples)	3378
lime	1260	(Schlumberger)	3370
shale & lime	1365	Burgess Sandstone	4085 DF
shale sdy & lime	1420	Miss. Limestone	4092 DF
shale	1480	Chattanooga Shale	4442 DF
lime	1530	Simpson (Wilcox) Sand-	
shale & lime	1570	stone	4510 DF
shale	1730	Total Depth	4563 DF
shale & shells	2095	good odor oil and gas,	
shale & lime	2140	s.f.o. 4087-92	
gyp & brk lime	2160	HDST 4085-95	
lime sdy	2215	open 34 min., rec. 200'	
lime & shale	2385	muddy salty wtr, SO&G	
shale	2435	Cored 4524-4530 SO&G	
shale & lime	2775	HDST 4516-30	
shale	2815	open 1 1/2 hrs, rec. 40'	
lime brkn	2845	muddy salty wtr	
shale hd	2870	Ran Schlumberger	
shale & lime	2930		
shale blk hd	2995		
shale	3020		
lime brkn	3044		
lime sdy	3115		
lime & shale	3155		
shale blk	3265		
shale	3379		
lime K.C.	3405		
lime brkn sft	3410		
lime & shale	3430		
lime	3575		
lime & shale	3645		
lime brkn	3655		
lime	3720		
lime & shale	3955		
shale & shells	4000		
lime	4010		
lime & shale	4090		
sand	4097		
lime cherty	4149		
lime dk	4165		
lime	4285		
lime & shale	4290		
lime	4310		
lime brkn	4330		
lime sft	4336		
lime hd	4353		
lime sdy	4358		
lime	4428		

**PLUGGING**  
 FILE 23 33 3W  
 BOOK 135 LINE 20

