


WELL PLUGGING RECORD

Give All Information Completely
Make Required Affidavit
Mail or Deliver Report to:
Conservation Division
State Corporation Commission
800 Bitting Building
Wichita, Kansas

Sumner County. Sec. 17 Twp. 35 Rge. (E) 3 (W)

Location as "NE/CNW/SW" or footage from lines SW NE NE
Lease Owner Time Petroleum Company
Lease Name Enderud-A Well No. 2
Office Address 500 Orpheum Bldg., Wichita, Kansas
Character of Well (completed as Oil, Gas or Dry Hole) Dry Hole
Date well completed 12-5- 19 52
Application for plugging filed 12-5- 19 52
Application for plugging approved 12-5- 19 52
Plugging commenced 12-5- 19 52
Plugging completed 12-5- 19 52
Reason for abandonment of well or producing formation _____

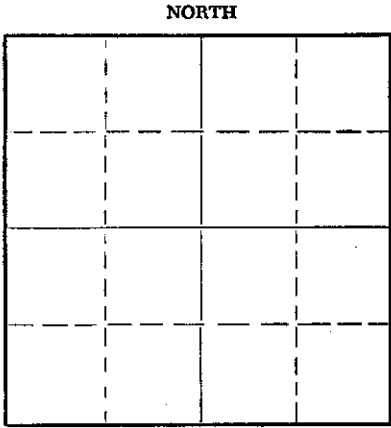

Locate well correctly on above Section Plat

If a producing well is abandoned, date of last production _____ 19 _____
Was permission obtained from the Conservation Division or its agents before plugging was commenced? Yes

Name of Conservation Agent who supervised plugging of this well W. A. Rives
Producing formation Simpson Depth to top 4865 Bottom 4875 Total Depth of Well 4900 Feet
Show depth and thickness of all water, oil and gas formations.

OIL, GAS OR WATER RECORDS

CASING RECORD

FORMATION	CONTENT	FROM	TO	SIZE	PUT IN	PULLED OUT
				10 3/4"	343'	none

Describe in detail the manner in which the well was plugged, indicating where the mud fluid was placed and the method or methods used in introducing it into the hole. If cement or other plugs were used, state the character of same and depth placed, from _____ feet to _____ feet for each plug set.

Hole filled with mud to 343 feet, set first plug. Place 15 Sacks cement on top of plug. Set second plug at 40 feet, hole filled to ground level with 15 sacks cement.

RECEIVED
STATE CORPORATION COMMISSION
DEC 12 1952
CONSERVATION DIVISION
Wichita, Kansas

(If additional description is necessary, use BACK of this sheet)
Name of Plugging Contractor Gabbert-Jones Drilling Company
Address 507 Orpheum Building, Wichita, Kansas

STATE OF Kansas COUNTY OF Sedgwick
Summet E. Hall (employee of owner) or (owner or operator) of the above-described well, being first duly sworn on oath, says: That I have knowledge of the facts, statements, and matters herein contained and the log of the above-described well as filed and that the same are true and correct. So help me God.
(Signature) Summet E. Hall
507 Orpheum Bldg, Wichita, Kansas (Address)

SUBSCRIBED AND SWORN TO before me this 10th day of December 19 52
Maryd. Lawrence Notary Public.

My commission expires Feb. 28, 1955

PLUGGING
FILE SEC 17 T 35 R 326
BOOK PAGE 63 LINE 11


GABBERT-JONES DRILLING COMPANY
WICHITA, KANSAS
DRILLER'S WELL LOG

Enderud #A-2
SW NE NE 17-35-3W
Sumner County, Kansas
Commenced 11-6-52
Completed 12-5-52

DEPTH		FORMATION	REMARKS
From	To		
0	40	Surface clay	
40	343	Shale & shells	Ran 343' of 10 3/4" casing, cemented w/175 sacks cement.
343	700	Shale & lime	
700	800	Shale	
800	1280	Shale & lime	
1280	1375	Lime	
1375	2425	Shale & lime	
2425	2595	Lime	
2595	2695	Lime & shale	
2695	2740	Lime	
2740	3260	Lime & shale	
3260	3430	Sand	
3430	3495	Lime	
3495	3575	Lime & shale	
3575	3630	Shale	
3630	3725	Lime & shale	
3725	4015	Lime	
4015	4075	Broken lime	
4075	4195	Lime	
4195	4255	Shale	
4255	4340	Shale & lime	
4340	4565	Lime	
4565	4600	Lime & shale	
4600	4678	Lime	
4678	4735	Lime & shale	
4735	4780	Lime	
4780	4820	Lime & shale	
4820	4855	Lime	
4855	4865	Shale	
4865	4875	Sand	
4875	4900	Lime	
4900	TD		Dry & Abandoned

PLUGGING
FILE SEC 17 T 35 R 3W
BOOK PAGE 63 LINE 41

Executed this 10th day of December 1952

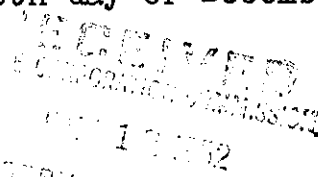
Ernest E. Hall

STATE OF KANSAS)
COUNTY OF SEDGWICK)
Wichita, Kansas

Before me, the undersigned, a Notary Public, within and for said County and State, on this 10th day of December, 1952, personally appeared Ernest E. Hall to me personally known to be the identical person who executed the within and foregoing instrument and acknowledged to me that he executed the same as his free and voluntary act and deed for the uses and purposes therein set forth.

IN WITNESS WHEREOF, I have hereunto set my hand and official seal the day and year last above written.

My commission expires Feb. 21, 1955 Mary L. Lawrence
Notary Public