

STATE OF KANSAS
STATE CORPORATION COMMISSION

Form CP-4


Give All Information Completely
Make Required Affidavit
Mail or Deliver Report to:
Conservation Division
State Corporation Commission
211 No. Broadway
Wichita, Kansas

WELL PLUGGING RECORD

Sumner County, Sec. 7 Twp. 32 Rge. 3W (E) (W)

Location as "NE/CNW&SW" or footage from lines C NE NW
Lease Owner Donald C. Slawson
Lease Name Edwards 'A' Well No. 1
Office Address 408 One Twenty Bldg. - Wichita, Kansas 67202
Character of Well (completed as Oil, Gas or Dry Hole) Dry Hole
Date well completed December 11 1966
Application for plugging filed December 11 1966
Application for plugging approved December 11 1966
Plugging commenced December 11 1966
Plugging completed December 11 1966
Reason for abandonment of well or producing formation Dry Hole

NORTH

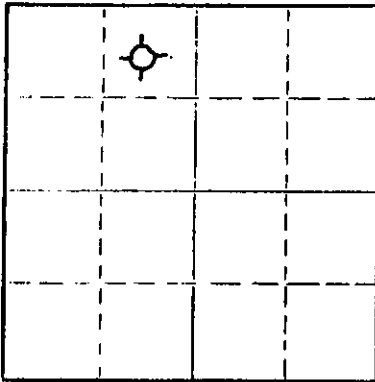

Locate well correctly on above
Section Plat

If a producing well is abandoned, date of last production 19
Was permission obtained from the Conservation Division or its agents before plugging was commenced? Yes

Name of Conservation Agent who supervised plugging of this well H. E. Hess-1422 Elizabeth-Winfield, Kansas
Producing formation _____ Depth to top _____ Bottom _____ Total Depth of Well 4440 Feet
Show depth and thickness of all water, oil and gas formations.

OIL, GAS OR WATER RECORDS

CASING RECORD

FORMATION	CONTENT	FROM	TO	SIZE	PUT IN	PULLED OUT

Describe in detail the manner in which the well was plugged, indicating where the mud fluid was placed and the method or methods used in introducing it into the hole. If cement or other plugs were used, state the character of same and depth placed, from _____ feet to _____ feet for each plug set.

Mud to 276 ft., set plug, cemented with 27 sx
Mud to 35 ft., set plug, cemented with 8 sx
2 sx in rathole

RECEIVED
STATE CORPORATION COMMISSION
DEC 16 1966
CONSERVATION DIVISION
Wichita, Kansas

(If additional description is necessary, use BACK of this sheet)

Name of Plugging Contractor Slawson Drilling Company, Inc.
Address 408 One Twenty Building - Wichita, Kansas 67202

STATE OF Kansas, COUNTY OF Sedgwick, ss.
DONALD C. SLAWSON (employee of owner) or (owner or operator) of the above-described well, being first duly sworn on oath, says: That I have knowledge of the facts, statements, and matters herein contained and the log of the above-described well as filed and that the same are true and correct. So help me God.

(Signature) [Signature]
408 One Twenty Building - Wichita, Kansas
(Address)

SUBSCRIBED AND SWORN to before me this 15th day of December, 19 66

My commission expires August 25, 1968
Ella Pries Notary Public.

R

WELL LOG

Company: Donald C. Slawson
408 One Twenty Building
Wichita, Kansas 67202

Farm: Edwards 'A' #1
C NE NW, Section 7-32-3W
Sumner County, Kansas

Total Depth: 4440' Elevation: 1263 K.B.

Commenced: November 28, 1966

Completed: December 11, 1966

Contractor: Slawson Drilling Company, Inc.

Casing: 8 5/8" at 262' with 190 sx of cement

0-25	Surface Clay
25-70	Shale & Shells
70-262	Lime & Shale
262-375	Shale & Shells
375-595	Shale & Lime
595-645	Lime
645-2370	Lime & Shale
2370-2978	Shale & Lime
2978-2988	Lime
2998-3098	Sand
3098-3102	Shale & Shells
3102-3297	Shale
3297-3576	Lime
3576-3607	Lime & Shale
3607-3789	Lime
3789-3808	Shale
3808-3948	Shale & Lime
3948-3964	Conglomerate
3964-4293	Lime
4293-4376	Shale & Lime
4376-4425	Shale
4425-4440	Sand
4440	Total Depth

RECEIVED
STATE CORPORATION COMMISSION

DEC 16 1966


CONSERVATION DIVISION
Wichita, Kansas

STATE OF KANSAS)
) SS:
COUNTY OF SEDGWICK)

I, Donald C. Slawson, of the Slawson Drilling Company, Inc., upon oath state that the above and foregoing is a true and correct copy of the log of the Edwards 'A' #1 well.


DONALD C. SLAWSON

Subscribed and sworn to before me this 14th day of December, 1966.


Ella Priess, Notary Public

My Commission Expires:
August 25, 1968