


STATE OF KANSAS
STATE CORPORATION COMMISSION

WELL PLUGGING RECORD

Give All Information Completely
Make Required Affidavit
Mail or Deliver Report to
Conservation Division
State Corporation Comm.
245 North Water
Wichita, KS 67202

Harper County, Sec. 18 Twp. 31 Rge. 8 E/W
Location as "NE/CNW/SW" or footage from lines
NW SW NE
Lease Owner Mill Drilling Company
Lease Name Darnes #2 Well No.
Office Address Wichita, Kansas 67202
Character of Well (Completed as Oil, Gas or Dry Hole)

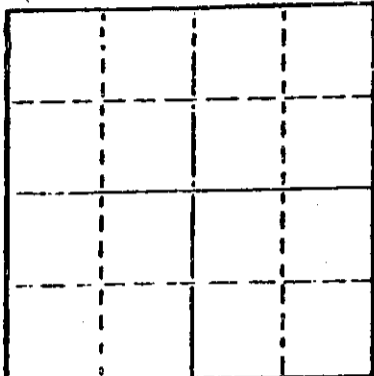

Locate well correctly on above
Section Plot

Date Well completed 19
Application for plugging filed 19
Application for plugging approved 19
Plugging commenced 6/6/77 19
Plugging completed 6/9/77 19
Reason for abandonment of well or producing formation
depleted.

If a producing well is abandoned, date of last production 19

Was permission obtained from the Conservation Division or
its agents before plugging was commenced? yes

Name of Conservation Agent who supervised plugging of this well Metz
Producing formation Depth to top Bottom Total Depth of Well 4422
Show depth and thickness of all water, oil and gas formations.

OIL, GAS OR WATER RECORDS

CASING RECORD

FORMATION	CONTENT	FROM	TO	SIZE	PUT IN	PULLED OUT
				8-5/8	211	none
				5 1/2"	4416	3832'

Describe in detail the manner in which the well was plugged, indicating where the mud fluid
was placed and the method or methods used in introducing it into the hold. If cement or other
plugs were used, state the character of same and depth placed, from feet to
feet for each plug set.

Made bottom hole plug back with sand to 4400' mixed and ran 5 sacks cement thru dump bailer.
Shot pipe at 3830', pulled 91 joints. Mudded hole to 250', set 15' rock bridge to 235',
filled hole with 3 1/2 yards ready mix from 235' to base of cellar.

PLUGGING COMPLETE.

(If additional description is necessary, use BACK of this sheet)

Name of Plugging Contractor KELSO CASING PULLING
CHASE, KANSAS

STATE OF KANSAS COUNTY OF RICE ss.
R. DABRELL KELSO (employee of owner) or (owner or operator) of the above-described
well, being first duly sworn on oath, says: That I have knowledge of the facts, statements, and matters herein contained and the log of the
above-described well as filed and that the same are true and correct. So help me God.

(Signature) *R. Dabrell Kelso*
CHASE, KANSAS (Address)

Subscribed and Sworn to before me this 13th day of June 1977

My commission expires



Margaret Melcher
Notary Public.

JUN 15 1977
6-15-77
CONSERVATION DIVISION
STATE OF KANSAS

ROTARY DRILLERS' LOG

OPERATOR: Mull Drilling Co., Inc.
415 Page Court
Wichita, Kansas 67202

DRILLING COMMENCED: 1 April 1977

CONTRACTOR: Graves Drilling Co., Inc.
910 Union Center
Wichita, Kansas 67202

DRILLING COMPLETED: 11 April 1977

CASING RECORD: 5 Jts. 211' of new 8 5/8"
cemented with 225 sacks;
105 Jts. 4416' of new 5 1/2"
cemented with 100 sacks

LOCATION: Darnes No. 2
NW SW NE
Section 18-31S-8W
Harper County, Kansas

- 0 - 100 Sand
- 100 - 865 Red bed
- 865 - 1498 Red bed, shale & lime
- 1498 - 2012 Shale & lime
- 2012 - 2168 Lime & shale
- 2168 - 2684 Shale
- 2684 - 2839 Lime & shale
- 2839 - 3113 Shale & lime
- 3113 - 3571 Lime & shale
- 3571 - 3850 Shale & lime
- 3850 - 4422 Lime & shale
- 4422 Rotary Total Depth

RECEIVED
CONSERVATION COMMISSION
APR 20 1977
4-20-77
CONSERVATION DIVISION
Wichita, Kansas

I hereby certify the foregoing statements to be true and correct to the best of my knowledge.

GRAVES DRILLING CO., INC.

By John Graves
President

STATE OF KANSAS)
) SS:
SEDGWICK COUNTY)

Subscribed and sworn to before me, a Notary Public, this 19th day of April, 1977

My commission expires: 2 February 1980

Courtney M. Graves
Courtney M. Graves Notary Public

