

2 040246

077-20973-0000

To: STATE CORPORATION COMMISSION  
CONSERVATION DIVISION - PLUGGING SECTION  
200 COLORADO DERBY BUILDING  
WICHITA, KANSAS 67202

API NUMBER 15- Old Haku

S.W. 50, SEC. 7, T. 31 S, R. 6 W

460 feet from N/S section line

4620 feet from W/E section line

TECHNICIAN'S PLUGGING REPORT

Operator License # 5123

Lease Name Bornholdt Well # C-1

Operator: Pickrell Drbg. Co.

County Harper 153.56

Name & Address 110 N. Market #205

Well Total Depth 4725 feet

Wichita Ks

Conductor Pipe: Size \_\_\_\_\_ feet

67202

Surface Casing: Size 8 3/8 feet 217

Abandoned Oil Well \_\_\_\_\_ Gas Well X Input Well \_\_\_\_\_ SWD Well \_\_\_\_\_ D&A \_\_\_\_\_

Other well as hereinafter indicated \_\_\_\_\_

Plugging Contractor Clark Corp. License Number \_\_\_\_\_

Address Medicine Lodge

Company to plug at: Hour: \_\_\_\_\_ Day: \_\_\_\_\_ Month: \_\_\_\_\_ Year: 19 \_\_\_\_\_

Plugging proposal received from Elmo

(company name) Clark Corp. (phone) \_\_\_\_\_

were: \_\_\_\_\_

4 1/2 4432 Sand 4258 TOC 4228

PBTD 4381 3 1/2 well 15 gel 100 sx

Perf. 4318-4322

Plugging Proposal Received by \_\_\_\_\_ (TECHNICIAN)

Plugging Operations attended by Agent?: All \_\_\_\_\_ Part X None \_\_\_\_\_

Operations Completed: Hour: 1030 Day: 24 Month: 1 Year: 19 86

ACTUAL PLUGGING REPORT Clark Corp. moved in over the hole. Sand was dumped into the 4 1/2" casing to cover the perforation. T.O.S. 4258', TOC 4228. The 4 1/2" casing was shot off and recovered from 3500'. The Top was squeeze plugged thru the 8 3/8" surface casing by pumping 3 sacks of hull, 5 sacks of gel, wiper plug, 80 sacks of cement, another wiper plug, and 20

Remarks: sacks of cement Allied Country #2148 MAX 500' HOLE DEPTH  
(If additional description is necessary, use BACK of this form.)

**INVOICED**

(You, the client, observe this plugging.)

DATE JAN 31 1986

INV. NO. 12218


WK

Signed Steve [Signature] (TECHNICIAN)

JAN 30 1986  
1-30-86  
CONSERVATION DIVISION  
Wichita, Kansas

New Completion     Workover 15-077-2073-0000

Oil Company \_\_\_\_\_ Well No. C-1 Field \_\_\_\_\_ Lease Bornholdt  
Company Man \_\_\_\_\_ Date Drilled Feb. 1984 County Harper State \_\_\_\_\_

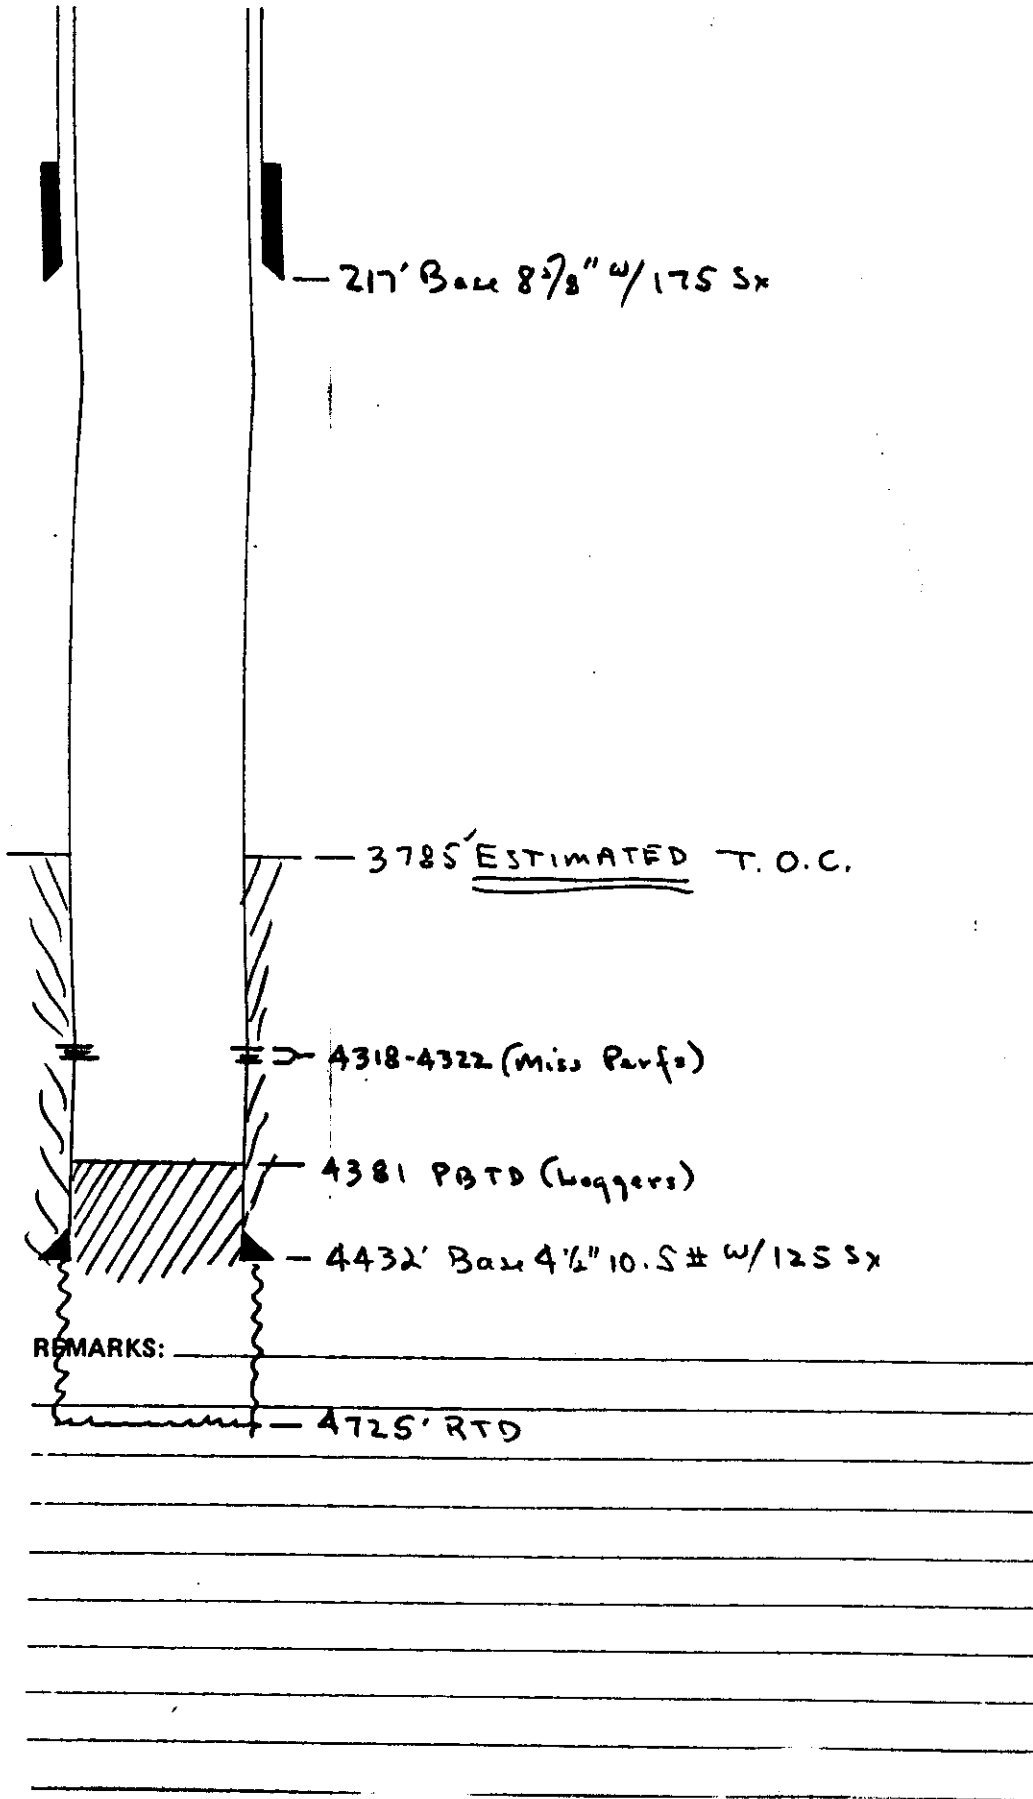

RECEIVED  
STATE CORPORATION COMMISSION

AUG 15 1985  
8-15-85  
CONSERVATION DIVISION  
Wichita, Kansas