

CARD MUST BE TYPED

State of Kansas

CARD MUST BE SIGNED

## NOTICE OF INTENTION TO DRILL

(see rules on reverse side)

Expected Spud Date. Sept. 26 1987  
 month day year

API Number 15— 165-21386-0000

OPERATOR: License # 5027  
 Name J. A. Allison  
 Address 300 West Douglas, Suite 305  
 City/State/Zip Wichita, Kansas 67202  
 Contact Person J. A. Allison  
 Phone 316-263-2241

NW NW NW Sec. 20 Twp. 18 S, Rg. 17 East  
4950 West  
 Ft. from South Line of Section  
4950 Ft. from East Line of Section

(Note: Locate well on Section Plat on reverse side)

CONTRACTOR: License # 5122  
 Name Woodman-Iannitti Drilling Co.  
 City/State Great Bend, Kansas 67530

Nearest lease or unit boundary line 330 feet  
 County Rush

Lease Name Gisick Well # 1  
 Ground surface elevation 2008 feet MSL

Well Drilled For: Well Class: Type Equipment:  
 Oil  Storage  Infield  Mud Rotary  
 Gas  Inj  Pool Ext.  Air Rotary  
 OWWO  Expl  Wildcat  Cable

Domestic well within 330 feet:  yes  no  
 Municipal well within one mile:  yes  no

Depth to bottom of fresh water 270'  
 Depth to bottom of usable water 470' (400' ~ Top Permian)

Surface pipe by Alternate: 1  2   
 Surface pipe planned to be set 1150'

Conductor pipe required None  
 Projected Total Depth 3760 feet  
 Formation Arbuckle

If OWWO: old well info as follows:

Operator  
 Well Name  
 Comp Date Old Total Depth

I certify that well will comply with K.S.A. 55-101, et seq., plus eventually plugging hole to KCC specifications.

Date Sept. 18, 1987 Signature of Operator or Agent J. A. Allison Title Operator

For KCC Use:  
 Conductor Pipe Required \_\_\_\_\_ feet; Minimum Surface Pipe Required 400 feet per Alt.   
 This Authorization Expires 3-21-88 Effective 9-26-87 Approved By FAA 9-21-87


Wax 836

Must be filed with the K.C.C. five (5) days prior to commencing well  
This card void if drilling not started within six (6) months of date received by K.C.C.

**Important procedures to follow:**

1. Notify District office before setting surface casing.
2. Set surface casing by circulating cement to the top.
3. File completion forms ACO-1 with K.C.C. within 120 days of well spud date, following instructions on ACO-1, side 1, and including copies of wireline logs.
4. Notify District office 48 hours prior to old well workover or re-entry.
5. Prior to filing Intent, prepare a proposed plugging plan in case well is D & A, then obtain approval of plan when calling district office prior to setting surface pipe.
6. Submit plugging report (CP-4) to K.C.C. after plugging is completed.
7. Obtain an approved injection docket number before disposing of salt water.
8. Notify K.C.C. within 10 days when injection commences or terminates.
9. On alternate 2 completion, cement in the production pipe from below any usable water to surface within 120 days of spud date.

**A Regular Section of Land  
1 Mile = 5,280 Ft.**

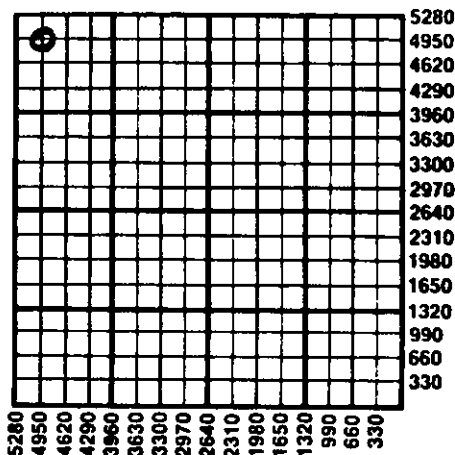

CONSERVATION  
Wichita, Kansas

SEP 21 1987  
9-21-87

STATE CORPORATION COMMISSION

State Corporation Commission of Kansas  
Conservation Division  
200 Colorado Derby Building  
Wichita, Kansas 67202-1212  
(316) 263-3238