

FOR KCC USE:

FORM C-1 7/91

FORM MUST BE TYPED

FORM MUST BE SIGNED

ALL BLANKS MUST BE FILLED

EFFECTIVE DATE: 4-19-2000

DISTRICT # 2

SEA?  Yes...  No

State of Kansas  
NOTICE OF INTENTION TO DRILL

Must be approved by the K.C.C. five (5) days prior to commencing well.

Expected Spud Date 04 14 2000  
month day year

Spot 70' W of  
C. E/2 NW-NE Sec 1 Twp 31 S, Rg 07 East West

OPERATOR: License # 9408  
Name: Trans Pacific Oil Corporation  
Address: 100 S. Main, Suite 200  
City/State/Zip: Wichita, KS 67202  
Contact Person: Alan D. Banta  
Phone: (316) 262-3596

660'  
1720' feet from South North line of Section  
feet from East West line of Section  
IS SECTION X REGULAR IRREGULAR?

(NOTE: Locate well on the Section Plat on Reverse Side)  
County: Harper  
Lease Name: Pomeroy Well #: 1-1  
Field Name: WIDEAT MAPLE GROVE SOUTH

CONTRACTOR: License #: 5929  
Name: Duke Drilling Co., Inc.

Is this a Prorated/Spaced field? .... yes X no  
Target Formation(s): Stalnaker, Mississippian

Nearest lease or unit boundary: 660'  
Ground Surface Elevation: 1580' est. feet MSL

Water well within one-quarter mile: .... yes X no  
Public water supply well within one mile: .... yes X no

Depth to bottom of fresh water: 80'  
Depth to bottom of usable water: 180'

Surface Pipe by Alternate: X 1 2  
Length of Surface Pipe Planned to be set: 250'

Length of Conductor pipe required: NONE  
Projected Total Depth: 4500'

Formation at Total Depth: Mississippian  
Water Source for Drilling Operations:

... well .... farm pond X ... other

Well Drilled For: Well Class: Type Equipment:  
X Oil ... Enh Rec X Infield X Mud Rotary  
X Gas ... Storage ... Pool Ext. ... Air Rotary  
... OMD ... Disposal ... Wildcat ... Cable  
... Seismic; ... # of Holes ... Other

If OMD: old well information as follows:  
Operator: N/A  
Well Name:  
Comp. Date: Old Total Depth

Directional, Deviated or Horizontal wellbore? .... yes X no  
If yes, true vertical depth:  
Bottom Hole Location:

Will Cores Be Taken?: N/A .... yes XX no  
If yes, proposed zone:

AFFIDAVIT

The undersigned hereby affirms that the drilling, completion and eventual plugging of this well will comply with K.S.A. 55-101, et. seq.

It is agreed that the following minimum requirements will be met:

1. Notify the appropriate district office prior to spudding of well;
2. A copy of the approved notice of intent to drill shall be posted on each drilling rig;
3. The minimum amount of surface pipe as specified below shall be set by circulating cement to the top; in all cases surface pipe shall be set through all unconsolidated materials plus a minimum of 20 feet into the underlying formation;
4. If the well is dry hole, an agreement between the operator and the district office on plug length and placement is necessary prior to plugging;
5. The appropriate district office will be notified before well is either plugged or production casing is cemented in;
6. IF AN ALTERNATE II COMPLETION, PRODUCTION PIPE SHALL BE CEMENTED FROM BELOW ANY USABLE WATER TO SURFACE WITHIN 120 DAYS OF SPUD DATE. IN ALL CASES, NOTIFY DISTRICT OFFICE PRIOR TO ANY CEMENTING.

I hereby certify that the statements made herein are true and to the best of my knowledge and belief.

Date: 4/11/00 Signature of Operator or Agent: [Signature] Title: Senior Vice President

FOR KCC USE:  
 API # 15- 077-213820000  
 Conductor pipe required NONE feet  
 Minimum surface pipe required 200 feet per Alt. (1) X  
 Approved by: [Signature] 4-14-2000  
 This authorization expires: 10-14-2000  
 (This authorization void if drilling not started within 6 months of effective date.)  
 Spud date: \_\_\_\_\_ Agent: \_\_\_\_\_

RECEIVED  
 KANSAS CORPORATION COMMISSION  
 APR 11 2000  
 4-11-00  
 CONSERVATION DIVISION  
 WICHITA KS

- REMEMBER TO:
- File Drill Pit Application (form CDP-1) with Intent to Drill;
  - File Completion Form ACO-1 within 120 days of spud date;
  - File acreage attribution plat according to field proration orders;
  - Notify appropriate district office 48 hours prior to workover or re-entry;
  - Submit plugging report (CP-4) after plugging is completed;
  - Obtain written approval before disposing or injecting salt water.

Mail to: KCC - Conservation Division, 130 S. Market - Room 2078, Wichita, Kansas 67202.

31  
7W

**IN ALL CASES PLOT THE INTENDED WELL ON THE PLAT BELOW**

**PLAT OF ACREAGE ATTRIBUTABLE TO A WELL IN A PRORATED OR SPACED FIELD**

If the intended well is in a prorated or spaced field, please fully complete this side of the form. If the intended well is in a prorated or spaced field complete the plat below showing that the well will be properly located in relationship to other wells producing from the common source of supply. Please show all the wells within 1 mile of the boundaries of the proposed acreage attribution unit for gas wells and within 1/2 mile of the boundaries of the proposed acreage attribution unit for oil wells.

API NO. 15- \_\_\_\_\_  
 OPERATOR Trans Pacific Oil Corp.  
 LEASE Pomeroy "A"  
 WELL NUMBER 1  
 FIELD wildcat

LOCATION OF WELL: COUNTY Harper  
660 feet from south/north line of section  
1720 feet from east/west line of section  
 SECTION I TWP 31S RG 7W



NUMBER OF ACRES ATTRIBUTABLE TO WELL \_\_\_\_\_  
 QTR/QTR/QTR OF ACREAGE \_\_\_\_\_

IS SECTION X REGULAR or \_\_\_\_\_ IRREGULAR  
IF SECTION IS IRREGULAR, LOCATE WELL FROM NEAREST CORNER BOUNDARY.

Section corner used: \_\_\_\_\_ NE \_\_\_\_\_ NW \_\_\_\_\_ SE \_\_\_\_\_ SW

**PLAT**

(Show location of the well and shade attributable acreage for prorated or spaced wells.)  
 (Show footage to the nearest lease or unit boundary line.)

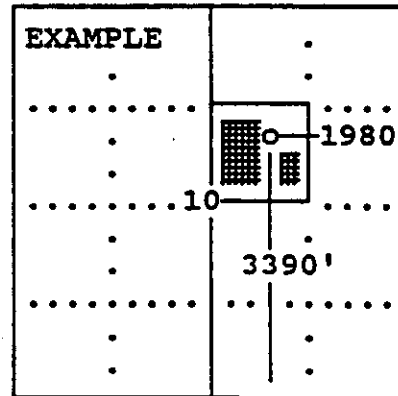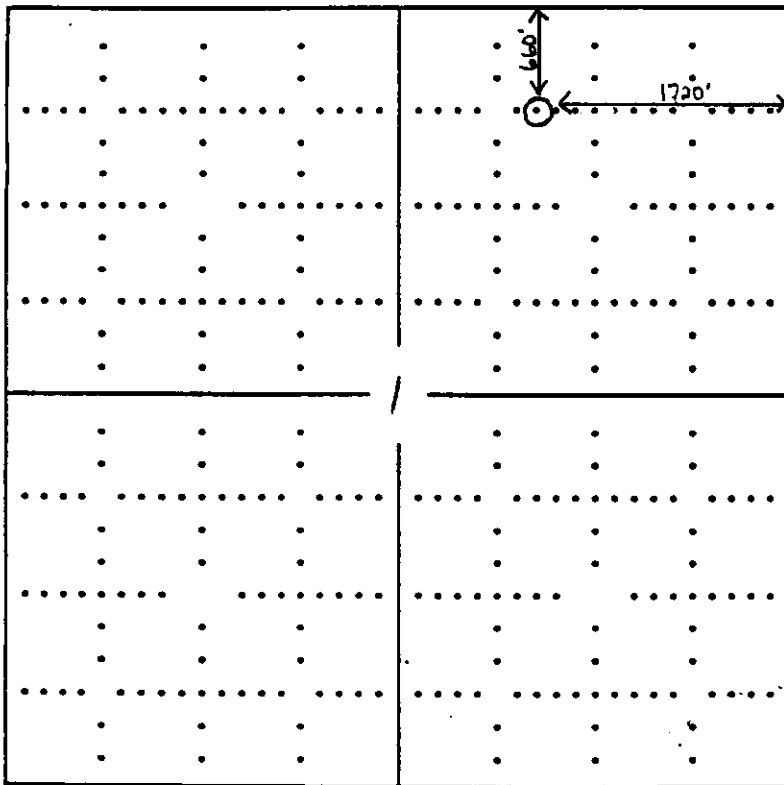

SEWARD CO.

**In plotting the proposed location of the well, you must show:**

- 1) The manner in which you are using the depicted plat by identifying section lines, i.e. 1 section, 1 section with 8 surrounding sections, 4 sections, etc.;
- 2) the distance of the proposed drilling location from the section's south/north and east/west; and
- 3) the distance to the nearest lease or unit boundary line.