


STATE OF KANSAS  
STATE CORPORATION COMMISSION

WELL PLUGGING RECORD

Give All Information Completely  
Make Required Affidavit  
Mail or Deliver Report to  
Conservation Division  
State Corporation Comm.  
245 North Water  
Wichita, KS 67202

Harper County, Sec. 26 Twp. 31S Rge. 6 E/W  
Location as "NE/CNW $\frac{1}{2}$ SW $\frac{1}{2}$ " or footage from lines  
SW SW NE NW

Lease Owner Robinowitz Oil Company  
Lease Name Stuckey Well No. #1  
Office Address 6650 South Lewis, Tulsa, Oklahoma 74136  
Character of Well (Completed as Oil, Gas or Dry Hole)  
Dry Hole

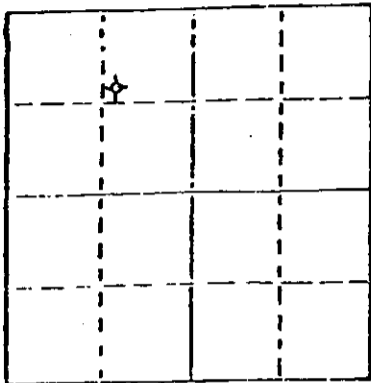

Locate well correctly on above  
Section Plat

Date Well completed 11-19-82 19  
Application for plugging filed 11-19-82 19  
Application for plugging approved 11-19-82 19  
Plugging commenced 11-19-82 19  
Plugging completed 11-19-82 19  
Reason for abandonment of well or producing formation

Commercial quantities of oil not found  
If a producing well is abandoned, date of last production 19

Was permission obtained from the Conservation Division or  
its agents before plugging was commenced? Yes

Name of Conservation Agent who supervised plugging of this well Maurice Leslie  
Producing formation Depth to top Bottom Total Depth of Well 4700'  
Show depth and thickness of all water, oil and gas formations.

OIL, GAS OR WATER RECORDS

CASING RECORD

FORMATION	CONTENT	FROM	TO	SIZE	PUT IN	PULLED OUT
				8 5/8"	314'	None

Describe in detail the manner in which the well was plugged, indicating where the mud fluid  
was placed and the method or methods used in introducing it into the hold. If cement or other  
plugs were used, state the character of same and depth placed, from feet to  
feet for each plug set.

Plug @ 750' w/30 sx.  
Plug @ 220' w/30 sx.  
Plug @ 60' w/20 sx.  
Rat Hole 10 sx.

(If additional description is necessary, use BACK of this sheet)

Name of Plugging Contractor Rains & Williamson Oil Co., Inc.


STATE OF Kansas COUNTY OF Sedgwick, ss.  
Wilson Rains, President of Rains & Williamson Oil Co., (employee of owner) or (owner or operator)  
of the above-described well, being first duly sworn on oath, says: That I have knowledge of  
the facts, statements, and matters herein contained and the log of the above-described well  
as filed and that the same are true and correct. So help me God.

(Signature) Wilson Rains  
435 Page Court, 220 W. Douglas, Wichita, Kansas 67202  
(Address)

SUBSCRIBED AND SWORN TO before me this 22 day of November, 19 82

My commission expires 10-4-83

Juanita M. Green  
Juanita M. Green Notary Public.

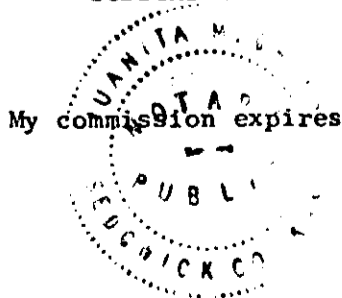

STATE CORPORATION COMMISSION  
12-13-82  
DEC 13 1982  
CONSERVATION DIVISION  
Wichita, Kansas

DRILLER'S LOG

COMPANY: Robinowitz Oil Company

SEC. 26 T. 31S R. 6W

LOC. SW SW NE NW

WELL NAME: Stuckey #1

COUNTY: Harper

RIG NO. #3

TOTAL DEPTH 4700'

ELEVATION

COMMENCED: 11-10-82

COMPLETED: 11-19-82

CONTRACTOR: Rains & Williamson Oil Co., Inc.

CASING RECORD:

SURFACE: 8 5/8" @ 314' w/250 sx. common, 2% gel, 3% cc.

PRODUCTION: D&A

LOG

(Figures Indicate Bottom of Formations)

Shale	3670
Lime	4585
Lime & Shale	4700
ROTARY TOTAL DEPTH	4700

STATE OF Kansas )

COUNTY OF Sedgwick )

SS:

I, Wilson Rains, President of Rains & Williamson Oil Co., Inc.

upon oath state that the above and foregoing is a true and correct copy of the log of the Stuckey #1 well.

*Wilson Rains*

Wilson Rains RECEIVED STATE COMMISSION

12-13-82 4:09 82 1982

NOT Subscribed and sworn to before me this 22 day of November



My Appointment Expires: 10-4-83

*Juanita M. Green*  
JUANITA M. GREEN  
CONSERVATION DIVISION  
Wichita Kansas