15-063-00109-0000


Form CP-4

STATE OF KANSAS
STATE CORPORATION COMMISSION

Give All Information Completely
Make Required Affidavit
Mail or Deliver Report to:
Conservation Division
State Corporation Commission
211 No. Broadway
Wichita, Kansas

WELL PLUGGING RECORD

NORTH

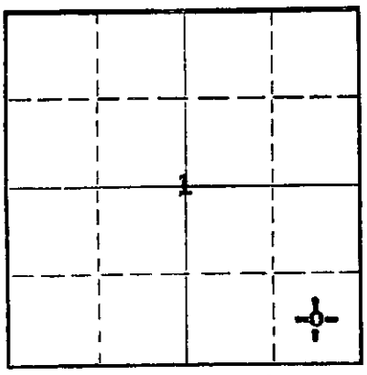

Locate well correctly on above Section Plat

Gove County. Sec. 1 Twp. 15S Rge. 26W (E) (W)

Location as "NE/CNW¼SW¼" or footage from lines C SE SE

Lease Owner D. R. Lauck Oil Company, Inc.

Lease Name Stutz Well No. 1

Office Address 301 S. Broadway, Wichita, Kansas

Character of Well (completed as Oil, Gas or Dry Hole) Dry Hole

Date well completed November 26, 1964

Application for plugging filed November 26, 1964

Application for plugging approved November 26, 1964

Plugging commenced November 26, 1964

Plugging completed November 26, 1964

Reason for abandonment of well or producing formation Dry Hole

If a producing well is abandoned, date of last production ____ 19____

Was permission obtained from the Conservation Division or its agents before plugging was commenced? Yes

Name of Conservation Agent who supervised plugging of this well Bill Nichols

Producing formation ____ Depth to top ____ Bottom ____ Total Depth of Well 4287 Feet

Show depth and thickness of all water, oil and gas formations.

OIL, GAS OR WATER RECORDS — CASING RECORD

FORMATION	CONTENT	FROM	TO	SIZE	PUT IN	PULLED OUT
		0'	211'	8-5/8"	211'	None

Describe in detail the manner in which the well was plugged, indicating where the mud fluid was placed and the method or methods used in introducing it into the hole. If cement or other plugs were used, state the character of same and depth placed, from ____ feet to ____ feet for each plug set.

4287'-540' Mud
540'-536' Plug
536'-496' Cement, 20 sacks
496'-216' Mud
216'-212' Plug
212'-172' Cement, 20 sacks
172'- 40' Mud
40'- 36' Plug
36'- 6' Cement, 10 sacks (Bottom of Cellar)

RECEIVED
STATE CORPORATION COMMISSION
DEC 9
12-09-64
CONSERVATION DIVISION
Wichita, Kansas

(If additional description is necessary, use BACK of this sheet)

Name of Plugging Contractor Globe Cementing Co.

Address Great Bend, Kansas

STATE OF KANSAS, COUNTY OF SEDGWICK, ss.

John H. Knightley (employee of owner) or (owner or operator) of the above-described well, being first duly sworn on oath, says: That I have knowledge of the facts, statements, and matters herein contained and the log of the above-described well as filed and that the same are true and correct. So help me God.

(Signature) John H. Knightley

301 S. Broadway, Wichita, Kansas
(Address)

SUBSCRIBED AND SWORN TO before me this 7th day of December, 1964

Stella J. Lipps
Notary Public.

My commission expires March 12, 1967

D. R. Lauck Oil Company, Inc.

Stutz #1

C SE SE Sec. 1-15S-26W
Gove County, Kansas

Commenced: November 13, 1964
Completed: November 26, 1964

Casing Record: 211' 8-5/8" Cemented with 160 sacks Cement, 3 sacks Calcium Chloride.

Elevation: 2268 GL; 2271 DF; 2273 KB.

Drillers Log

Sand	19
Rock	30
Shale	830
Sand	909
Shale	990
Red Bed, Shale, Shells	1165
Shale w/sand streaks	1535
Shale, Red Bed, & Shells	1750
Anhydrite & Shale	1790
Shale & Shells	2281
Shale with lime streaks	2380
Shale & Lime	2697
Lime & Shale	2784
Shale & Lime	2935
Lime & Shale	3045
Shale & Lime	3490
Lime & Shale	3590
Lime	3663
Lime & Shale	3725
Lime	3825
Lime & Shale	3862
Lime	3990
Lime & Shale	4212
Sand & Chert	4216
Cherty lime & shale	4245
Lime	4287 RTD

Tops

	Sample	Welex
Anhydrite	1750 +523	
Heebner	3561-1288	3562-1289
Toronto	3580-1307	3582-1309
Lansing	3600-1327	3603-1330
Base Kansas City	3893-1620	3894-1621
Pawnee	3997-1724	4004-1767
Ft. Scott	4037-1764	4040-1767
Cherokee Shale	4095-1822	4095-1822
Sand	4198-1925	4195-1922
Mississippian	4232-1959	4216-1943
Total Depth	4287-2014	4289-2016

DST #1 (S) 4192-4216, open 1 hr. with weak blow 13 minutes. Recovered 3' drilling mud.

ISIP 61#/30 min.
FSIP 61#/30 min.
IFP 36#
FFP 36#

D&A

RECEIVED
STATE CORPORATION COMMISSION

DEC 9 1964

CONSERVATION DIVISION
Wichita, Kansas

I hereby certify that this is a true and correct log of the above mentioned well, to the best of my knowledge and belief.

John D. Lauck

Subscribed and sworn to before me this 2nd day of December 19 64

Stella J. Lippe
Notary Public

My commission expires 3-12-67