


15-077-30161-0000

STATE OF KANSAS
STATE CORPORATION COMMISSION

Form CP-4

WELL PLUGGING RECORD

Give All Information Completely
Make Required Affidavit
Mail or Deliver Report to:
Conservation Division
State Corporation Commission
P. O. Box 17027
Wichita, Kansas 67217
NORTH

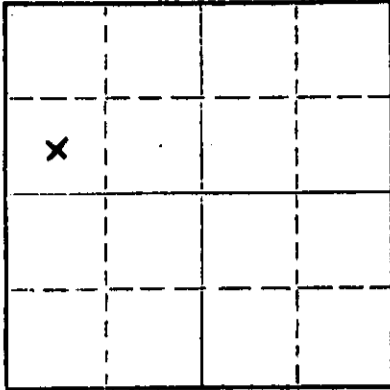

Locate well correctly on above
Section Plat

Harper County. Sec. 1 Twp. 31 Rge. 7 (E) W (W)
Location as "NE/CNWSW" or footage from lines C SW NW
Lease Owner Pickrell Drilling Co.
Lease Name Joslin 'A' Well No. #1
Office Address 205 4th Nat'l Bank Bldg. ; Wichita, Ks. 67202
Character of Well (completed as Oil, Gas or Dry Hole) Gas
Date well completed July 8 1966
Application for plugging filed August 29 1972
Application for plugging approved August 30 1972
Plugging commenced August 29 1972
Plugging completed August 31 1972
Reason for abandonment of well or producing formation Well Depleted

If a producing well is abandoned, date of last production July 28 1972
Was permission obtained from the Conservation Division or its agents before plugging was commenced? Yes

Name of Conservation Agent who supervised plugging of this well Russell Biberstein
Producing formation Mississippian Depth to top 4335 Bottom 4359 Total Depth of Well 4735 Feet
Show depth and thickness of all water, oil and gas formations.

OIL, GAS OR WATER RECORDS

CASING RECORD

FORMATION	CONTENT	FROM	TO	SIZE	PUT IN	PULLED OUT
				8 5/8"	205	None
				4 1/2"	4400	2995

Describe in detail the manner in which the well was plugged, indicating where the mud fluid was placed and the method or methods used in introducing it into the hole. If cement or other plugs were used, state the character of same and depth placed, from _____ feet to _____ feet for each plug set.

August 29, 1972 Plugged off bottom. Dumped sand to 4300'.
Mixed and dumped 4 sx of cement,
August 31, 1972 Plugged off top. Set 10' rock bridge at 220'.
Filled 8 5/8" surface casing from 220' to base
of cellar with 3000 lb. P.S.I. ready-mix concrete.


RECEIVED
STATE CORPORATION COMMISSION
SEP 19 1972
9-19-72
CONSERVATION DIVISION
Wichita, Kansas

(If additional description is necessary, use BACK of this sheet)
Name of Plugging Contractor RISS CASING PULLING, INC.
Address P. O. Box 1082 ; Great Bend, Kansas 67530

STATE OF Kansas, COUNTY OF Sedgwick, ss.
Dale M. Robinson (employee of owner) or (owner or operator) of the above-described well, being first duly sworn on oath, says: That I have knowledge of the facts, statements, and matters herein contained and the log of the above-described well as filed and that the same are true and correct. So help me God.

(Signature) Dale M. Robinson
705 Fourth National Bank Bldg., Wichita, Kansas
(Address)

SUBSCRIBED AND SWORN to before me this 18th day of September, 19 72

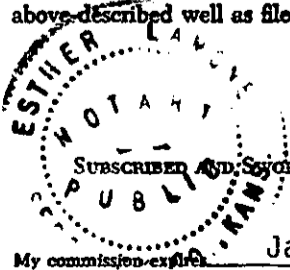

My commission expires January 19, 1973
Esther Lamone Notary Public.

15-077-3016-0000
ROTARY DRILLING LOG

COMPANY: Pickrell Drilling Company
 705 4th National Bank Bldg.
 Wichita, Kansas
 LOCATION: Joslin "A" No. 1, C SW NW Section 1-31S-7W, Harper County, Kansas.

Rotary Drilling Commenced 6-2-66
 Rotary Drilling Completed 6-15-66

CONTRACTOR: **PICKRELL DRILLING COMPANY**
 Wichita, Kansas

CASING RECORD: (10 jts) 205' of 8 5/8" surface casing set with 170 sacks cement.
 Circulated. (140 jts) 4 1/2" casing set at 4400' with 230 sacks
 cement. Completed 6:00 P.M. June 16, 1966.

LOG

(Figures indicate bottom of formation — measurements from top of rotary bushing.)

80	Sand	<u>C. F. S.</u>
205	Red Rock	3553
420	Red Bed & Shale	3940
1320	Shale & Shells	3973
1520	Lime	4349
3480	Lime & Shale	4359
3530	Shale	4710
3553	Stalnaker-Sand	4716
3800	Lime & Shale	4723
3875	Lime-K.C.	4733
4068	Lime	4735
4195	Lime & Shale	
4250	Lime	
4305	Lime & Shale	
4578	Mississippian	<u>Slope Test</u>
4633	Shale & Lime	2000
4695	Kinderhook	3000
4735	Simpson - RTD	4000
		4500

RECEIVED
 STATE CORPORATION COMMISSION

AUG 30 1972
 8-30-72
 CONSERVATION DIVISION
 Wichita, Kansas

S. L. M.

2603

3480

4308

The undersigned, C. W. SEBITS, Attorney-in-Fact for PICKRELL DRILLING COMPANY, hereby certifies in behalf of said Company, that the above is a true and correct log of the formation encountered in drilling the above well as reflected by the Daily Drilling Reports.

PICKRELL DRILLING COMPANY

By C. W. SEBITS, Attorney-in-Fact

STATE OF KANSAS }
 COUNTY OF SEDGWICK } ss.:

On this 21st day of June, 19 66, before me the undersigned, a Notary Public, in and for the County and State aforesaid, personally appeared C. W. SEBITS, to me known to be the identical person who subscribed the name of PICKRELL DRILLING COMPANY to the foregoing instrument as its Attorney-in-Fact and acknowledged to me that he executed the same as his free and voluntary act and deed, and as the free and voluntary act and deed of such company, for the uses and purposes therein set forth.

Given under my hand and seal of office the day and year last above written.

My commission expires: May 10, 1970

L. M. Whiting
 L. M. Whiting, Notary Public