


STATE OF KANSAS
STATE CORPORATION COMMISSION

WELL PLUGGING RECORD

Give All Information Completely
Make Required Affidavit
Mail or Deliver Report to
Conservation Division
State Corporation Comm.
245 North Water
Wichita, KS 67202

Harper County. Sec. 1 Twp. 31 Rge. 7W E/W
Location as "NE/CNW $\frac{1}{4}$ SW $\frac{1}{4}$ " or footage from lines
1750' FNL & 2000' FWL (N $\frac{1}{2}$ SE NW)
Lease Owner Wells Energy Corp.
Lease Name Joslin Well No. 1
Office Address Suite 454, 700 S. Colorado Blvd., Denver
Character of Well (Completed as Oil, Gas or Dry Hole) CO
Dry Hole 80222
Date Well completed June 18, 1980
Application for plugging filed Verbal Application 19
Application for plugging approved Verbal Approval 19
Plugging commenced June 18, 1980
Plugging completed June 18, 1980
Reason for abandonment of well or producing formation

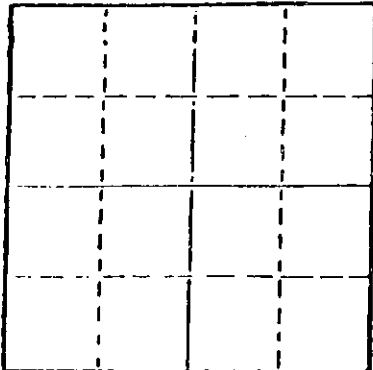

Locate well correctly on above
Section Plot

If a producing well is abandoned, date of last production 19

Was permission obtained from the Conservation Division or
its agents before plugging was commenced? Yes

Name of Conservation Agent who supervised plugging of this well William T. Owen
Producing formation Depth to top Bottom Total Depth of Well 3,579'
Show depth and thickness of all water, oil and gas formations.

OIL, GAS OR WATER RECORDS

CASING RECORD

FORMATION	CONTENT	FROM	TO	SIZE	PUT IN	PULLED OUT
				8-5/8"	254'	None

Describe in detail the manner in which the well was plugged, indicating where the mud fluid
was placed and the method or methods used in introducing it into the hold. If cement or other
plugs were used, state the character of same and depth placed, from _____ feet to
_____ feet for each plug set.

Filled hole with heavy rotary mud from 3,579 ft. (rotary total depth) to
260 ft. Set plug at 260 ft. and cemented with 40 sacks cement. Filled
hole with heavy rotary mud from 260 ft. to 40 ft. Set solid plug at 40 ft.
and cemented with 10 sacks cement, 5 sacks cement in rat hole and 2 sacks
cement in water well.

Plugging operations accomplished utilizing Halliburton Oil well cementing
pump truck through 4 $\frac{1}{2}$ inch drill pipe.

(If additional description is necessary, use BACK of this sheet)

Name of Plugging Contractor Halliburton Services
410 Union Center Bldg., Wichita, Kansas 67202

STATE OF Kansas COUNTY OF Sedgwick, ss.
Dean Britting, Agent (EMPLOYEE of owner XXXXownerXXXXoperator)

of the above-described well, being first duly sworn on oath, says: That I have knowledge of
the facts, statements, and matters herein contained and the log of the above-described well
as filed and that the same are true and correct. So help me God.

(Signature) Dean Britting
251 N. Water #10 Wichita, Kansas 67202
(Address)

SUBSCRIBED AND SWORN TO before me this 3rd day of July, 1980

My commission expires July 25, 1982

Elsie Willison
Elsie Willison - Notary Public.

RECEIVED
STATE CORPORATION COMMISSION
7-11-80
JUL 11 1980

CONSERVATION DIVISION
Wichita, Kansas

KANSAS DRILLERS LOG

COMPANY Wells Energy Corporation

SEC 1 T31 R 7W
LOC 1750' FNL & 2000' FWL
(N/2 SE NW)

FARM Joslin NO. 1

COUNTY Harper

ROTARY TOTAL DEPTH 3,579'
COMM. June 10, 1980 COMP. June 18, 1980
CONTRACTOR H-30, INC. (Rig #3)
ISSUED July 3, 1980

CASING

10 3/4"
8 5/8" Set at 254' cemented w/200 sxs cement ELEVATION 1,574' K.B.
5 1/2"
4 1/2"

FIGURES INDICATE BOTTOM OF FORMATIONS

Sand	55'
Red Bed and Shale	1,140'
Lime and Shale	1,515'
Shale and Lime	1,735'
Lime and Shale	3,524'
Lime	3,529'
Lime and Shale	3,579'
Rotary Total Depth	3,579'


I hereby certify the above and foregoing to be a true and correct log of the above described well as shown by the drilling reports.

H-30, INC.

Dean Britting
Dean Britting

State of Kansas)
) ss:
County of Sedgwick)

Subscribed and Sworn to before me a Notary Public
in and for said county and state this 3rd day of
July, 1980.

 

Elsie Willison
Elsie Willison - Notary Public

My Commission Expires:
July 25, 1982

RECEIVED
STATE CORPORATION COMMISSION

JUL 11 1980
7-11-80
CONSERVATION DIVISION
Wichita, Kansas