


15-077-00028-0000

STATE OF KANSAS
STATE CORPORATION COMMISSION

WELL PLUGGING RECORD

Give All Information Completely
Make Required Affidavit
Mail or Deliver Report to:
Conservation Division
State Corporation Commission
800 Bitting Building
Wichita, Kansas

Harper County. Sec. 10 Twp. 31 Rge. 8 (E) W (W)
Location as "NE/CNW/SW" or footage from lines SW SW NE
Lease Owner Beardmore Drilling Company
Lease Name Muir Well No. 1 D
Office Address 827 Beacon Building, Wichita, Kansas
Character of Well (completed as Oil, Gas or Dry Hole) Dry Hole
Date well completed 8-13 1955
Application for plugging filed 8-13 1955
Application for plugging approved 8-13 1955
Plugging commenced 8-13 1955
Plugging completed 8-13 1955
Reason for abandonment of well or producing formation Dry Hole

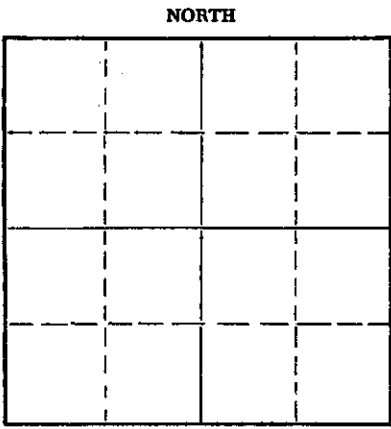

Locate well correctly on above
Section Plat

If a producing well is abandoned, date of last production _____ 19____
Was permission obtained from the Conservation Division or its agents before plugging was commenced? Yes

Name of Conservation Agent who supervised plugging of this well M. A. Rives
Producing formation _____ Depth to top _____ Bottom _____ Total Depth of Well 4505 Feet
Show depth and thickness of all water, oil and gas formations.

OIL, GAS OR WATER RECORDS

CASING RECORD

FORMATION	CONTENT	FROM	TO	SIZE	PUT IN	PULLED OUT
	Shale	0	1	8 5/8	154	0

Describe in detail the manner in which the well was plugged, indicating where the mud fluid was placed and the method or methods used in introducing it into the hole. If cement or other plugs were used, state the character of same and depth placed, from _____ feet to _____ feet for each plug set.

0 to 35' - 10 sacks cement.

35' - Wood Plug

35 to 125' - Heavy Mud

125 to 200' - 25 sacks cement.

200' - Wood Plug

200 to 4505' - Heavy Mud

(If additional description is necessary, use BACK of this sheet)

Name of Plugging Contractor Beardmore Drilling Company
Address 827 Beacon Building, Wichita, Kansas

STATE OF Kansas, COUNTY OF Sedgwick, ss.
Heber Beardmore (employee of owner) or (owner or operator) of the above-described well, being first duly sworn on oath, says: That I have knowledge of the facts, statements, and matters herein contained and the log of the above-described well as filed and that the same are true and correct. So help me God.

(Signature) Heber Beardmore
Heber Beardmore

SUBSCRIBED AND SWORN TO before me this 15th day of August, 1955

My commission expires January 28, 1956

RECEIVED
STATE CORPORATION COMMISSION

AUG 16 1955
8-16-55
CONSERVATION DIVISION
Wichita, Kansas

PLUGGING
FILE SEC 10 T 31 R 8 W
BOOK PAGE 142 LINE 31

BEARDMORE-SUTTON
 #1D Muir
 SW SW NE
 Sec. 10-31S-8W, Harper County

Drilled By: Beardmore Drilling Company
 Drilling Commenced: 7-31-55
 Drilling Completed: 8-13-55

Casing Record:

Set 156' of 8 5/8" with 110 sacks. Cement circulated. 7-31-55

Elevations: KB 1651
 DF 1648
 Gr 1645

<u>FORMATIONS</u>	<u>DEPTH</u>
Cellar	5
Sand	85
Red Beds and Shale	154
Red Rock and Shale	700
Shale	960
Shale and Lime	1500
Lime - broken	1750
Lime and Shale	1950
Lime and Shale	3020
Lime and Shale	3525
Sand	3595
Lime and Shale	3708
Lime and Shale	3945
Lime	4085
Lime and Shale	4225
Lime	4280
Lime and Shale	4385
Lime and Chert	4430
Lime	4505
Total Depth	4505

TOPS

Kansas City	3900
Mississippi	4404

- DRILL STEM TEST #1 4407-4414' - Open 1 hr. Gas in 4 min., 300,000 c.f.est. Recovered 40' gas cut mud. I.F. 0 - F.F. 70 - B.H.P. 1330 in 20 min.
- DRILL STEM TEST #2 4415-4430' - Open 1 hr. Gas in 27 min., not enough to measure. Recovered 70' slightly oil and gas cut mud, 60' heavily oil and gas cut mud. I.F. 0 - F. F. 0 - B.H.P. 210 in 20 min.
- DRILL STEM TEST #3 4431-4448 - Open 1 hr. Recovered 60' gas cut and slightly oil cut mud, 60' gas cut and oil cut mud, 60' gas cut and oil cut mud and water, 60' gas and oil cut watery mud, 30' water. I.F. 80 - F.F. 80 - B.H.P. 1130 in 20 min.

RECEIVED
 STATE CORPORATION COMMISSION
 AUG 16 1955
 8-16-55
 CONSERVATION
 Wichita, Kansas

STATE OF KANSAS }
 COUNTY OF SEDGWICK } ss

I, the undersigned, being duly sworn on oath state that the above and within statement is a true and correct record and log of the well drilled on the location above-described, to the best of my knowledge and belief.

Robert J. Gutru
 Robert J. Gutru

Subscribed and sworn to before me this 15th day of August, 1955.

PLUGGING
 FILE NO. 10-31-8200
 PAGE 142 LINE 31

Leonard P. Tolle
 Notary Public

My Commission Expires
 January 28, 1956