

STATE OF KANSAS  
STATE CORPORATION COMMISSION


WELL PLUGGING RECORD

Give All Information Completely  
Make Required Affidavit  
Mail or Deliver Report to  
Conservation Division  
State Corporation Comm.  
245 North Water  
Wichita, KS 67202

Harper County. Sec. 10 Twp. 31S Rge. 8 X/W  
Location as "NE/CNW $\frac{1}{2}$ SW $\frac{1}{2}$ " or footage from lines  
1980' FSL & 1420' FEL

Lease Owner TEXAS OIL & GAS CORP.  
Lease Name Muir "A" Well No. 1  
Office Address 200 W. Douglas, Suite 300, Wichita KS 67202  
Character of Well (Completed as Oil, Gas or Dry Hole) \_\_\_\_\_  
Dry Hole

Date Well completed 4-14-77 19  
Application for plugging filed 4-14-77 19  
Application for plugging approved 4-14-77 19  
Plugging commenced 4-14-77 19  
Plugging completed 4-14-77 19  
Reason for abandonment of well or producing formation \_\_\_\_\_

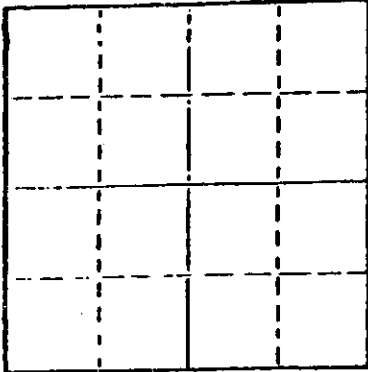

Locate well correctly on above  
Section Plat

If a producing well is abandoned, date of last production \_\_\_\_\_ 19

Was permission obtained from the Conservation Division or  
its agents before plugging was commenced? Yes

Name of Conservation Agent who supervised plugging of this well Dwayne Rankin, Gt. Bend KS  
Producing formation \_\_\_\_\_ Depth to top \_\_\_\_\_ Bottom \_\_\_\_\_ Total Depth of Well 4525'  
Show depth and thickness of all water, oil and gas formations.

OIL, GAS OR WATER RECORDS

CASING RECORD

FORMATION	CONTENT	FROM	TO	SIZE	PUT IN	PULLED OUT
		0	266'	8 5/8'	X	

Describe in detail the manner in which the well was plugged, indicating where the mud fluid  
was placed and the method or methods used in introducing it into the hold. If cement or other  
plugs were used, state the character of same and depth placed, from \_\_\_\_\_ feet to  
\_\_\_\_\_ feet for each plug set.

Heavy mud from T.D. to 240' 35 sack cement, mud to 40'  
1/2 sack hulls plug bridge 15 sacks base of cellar 5  
sacks rat hole

RECEIVED  
STATE CORPORATION COMMISSION

APR 28 1977

4-28-77  
CONSERVATION DIVISION  
Wichita, Kansas

(If additional description is necessary, use BACK of this sheet)  
Name of Plugging Contractor Xplor Drilling Co.


STATE OF KANSAS COUNTY OF SEDGWICK, ss.  
Wayne L. Kirkman (producer of well) or (owner or operator)  
of the above-described well, being first duly sworn on oath, says: That I have knowledge of  
the facts, statements, and matters herein contained and the log of the above-described well  
as filed and that the same are true and correct. So help me God.

(Signature) Wayne L. Kirkman  
180 S. Rock Road, Suite 300, Wichita KS  
(Address)

SUBSCRIBED AND SWORN TO before me this 20th. day of April, 19 77

Virginia Lee Smith  
Notary Public.

My commission expires August 25, 1980

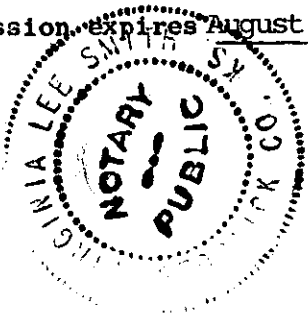

WELL LOG

MJIR "A" #1  
 1980' FSL & 1420' FEL  
 Section 10-31S-8W  
 Harper County, Kansas

OPERATOR: TEXAS OIL & GAS CORP.  
 CONTRACTOR: XPLOR DRILLING CO.

COMMENCED: 4-3-77  
 COMPLETED: 4-14-77

CASING RECORD: Ran 6 jts. new 8 5/8" 24#, set @266'. Cement with 250 sacks common cement 3% cal.chloride, 2% gel.

<u>FORMATION</u>	<u>FROM</u>	<u>TO</u>	<u>ELEVATION</u>
Surface Soil	0	60	1628' GR.
Sand	60	95	1633' D.F.
Red Bed	95	980	1636' K.B.
Lime	980	1847	
Lime & Shale	1847	4399	
Lime	4399	4525	
RTD	4525		

RECEIVED  
 STATE CORPORATION COMMISSION

APR 28 1977  
 4-28-77  
 CONSERVATION DIVISION  
 Wichita, Kansas

STATE OF KANSAS )  
 ) SS:  
 COUNTY OF SEDGWICK )

I Certify that this is a true and correct copy of the Driller's Log of the well drilled 1980' FSL & 1420' FEL in Section 10-31S-8W, Harper County, Kansas, to the best of my knowledge and belief.

XPLOR DRILLING CO.

*Wayne L. Kirkman*  
 \_\_\_\_\_  
 Wayne L. Kirkman, Owner

Subscribed and sworn to before me this 20th. day of April, 1977.

MY COMMISSION EXPIRES:  
 August 25, 1980

*Virginia Lee Smith*  
 \_\_\_\_\_  
 Virginia Lee Smith, Notary Public

