

STATE OF KANSAS
STATE CORPORATION COMMISSION

WELL PLUGGING RECORD

Give All Information Completely
Make Required Affidavit
Mail or Deliver Report to
Conservation Division
State Corporation Comm.
245 North Water
Wichita, KS 67202

Harper County, Sec. 20 Twp. 31S Rge. 6 W R/W
Location as "NE/CNW $\frac{1}{4}$ SW $\frac{1}{4}$ " or footage from lines
SE SW

Lease Owner Tomlinson Oil Co., Inc.
Lease Name Squire Well No. #1

Office Address 200 West Douglas, Suite 1030, Wichita, Kansas
Character of Well (Completed as Oil, Gas or Dry Hole)

Dry Hole

Date Well completed 11-3 1977
Application for plugging filed 11-3 1977
Application for plugging approved 11-3 1977
Plugging commenced 11-3 1977
Plugging completed 11-3 1977

Reason for abandonment of well or producing formation
Dry Hole


If a producing well is abandoned, date of last production
19

Was permission obtained from the Conservation Division or
its agents before plugging was commenced? Yes

Name of Conservation Agent who supervised plugging of this well Bill Owens

Producing formation Depth to top Bottom Total Depth of Well

Show depth and thickness of all water, oil and gas formations.

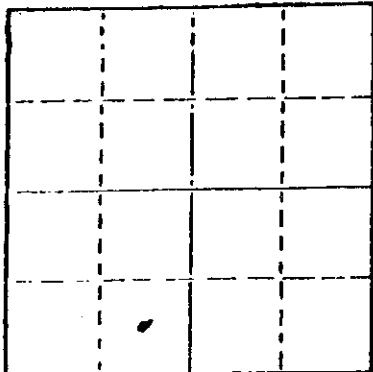

Locate well correctly on above
Section Plat

OIL, GAS OR WATER RECORDS

CASING RECORD

FORMATION	CONTENT	FROM	TO	SIZE	PUT IN	PULLED OUT
Surface Pipe		-0-	211	8 5/8"	211	NONE

Describe in detail the manner in which the well was plugged, indicating where the mud fluid was placed and the method or methods used in introducing it into the hold. If cement or other plugs were used, state the character of same and depth feet to feet for each plug set.

Filled Hole with heavy mud.

- #1 Plug set @ 230' with 35 sks. cement.
- #2 Plug set @ 40' with 12 sks. cement.
- #3 Plug set in rat hole with 3 sks. cement.

RECEIVED
STATE CORPORATION COMMISSION
NOV 14 1977
11-14-77
CONSERVATION DIVISION
Wichita, Kansas

(If additional description is necessary, use BACK of this sheet)

Name of Plugging Contractor Sweetman Drilling, Inc.

STATE OF Kansas COUNTY OF Barton, ss.
Gary L. Hawk (employee of owner) or (operator)


of the above-described well, being first duly sworn on oath, says: That I have knowledge of the facts, statements, and matters herein contained and the log of the above-described well as filed and that the same are true and correct. So help me God.

(Signature) Gary L. Hawk
Box 645, Great Bend, Kansas 67530
(Address)

SUBSCRIBED AND SWORN TO before me this 11th day of November, 1977

Mary Ann Schwamborn
Notary Public.

My commission expires 8-1-81

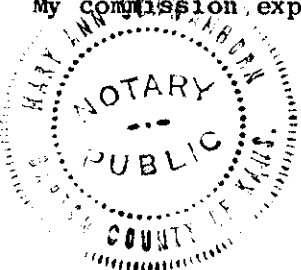

WELL LOG
Squire #1
SE SW 20-31S-6W
Harper County, Kansas

Name of Operator: Tomlinson Oil Co., Inc.
200 West Douglas Suite 1030
Wichita, Kansas 67202

Date Completed: November 3, 1977

<u>FROM</u>	<u>TO</u>	
0	1203	Red bed and shale
1203	3520	Lime and shale
3520	3570	Stal. sand
3570	4010	Lime and shale
4010	4350	Lime
4350		Total Depth

RECEIVED
STATE COMMISSION

NOV 14 1977
11-14-77
CONSERVATION DIVISION
Wichita, Kansas

STATE OF KANSAS

COUNTY OF BARTON ss

Gary L. Hawk, Secretary of Sweetman Drilling, Inc., being first duly sworn on oath says: That I have knowledge of the facts, statements and matters herein contained and the log of the above described well as filed and that the same are true and correct.

Gary L. Hawk
Gary L. Hawk

Subscribed and sworn before me this 9th day of November, 1977.

Mary Ann Schwamborn
Notary Public Barton County

My Commission Expires 8-1-81

