


STATE OF KANSAS
STATE CORPORATION COMMISSION

WELL PLUGGING RECORD

Give All Information Completely
Make Required Affidavit
Mail or Deliver Report to
Conservation Division
State Corporation Comm.
245 North Water
Wichita, KS 67202

Harper County, Sec. 20 Twp. 31S Rge. 6 XEY/W
Location as "NE/CNW $\frac{1}{2}$ SW $\frac{1}{2}$ " or footage from lines
C N/2 N/2 NW
Lease Owner Hummon Oil Company & Leonard M. Ropfogel
Lease Name Davis Well No. 1
Office Address 1725 Vickers KSB&T Bldg, Wichita, Ks. 67202
Character of Well (Completed as Oil, Gas or Dry Hole)

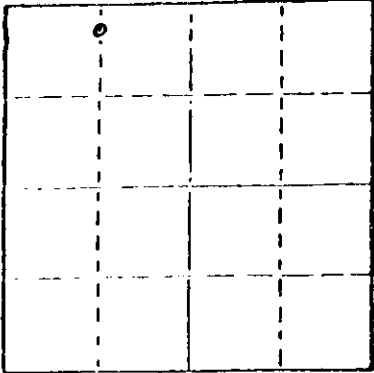

Locate well correctly on above
Section Plat

Dry Hole
Date Well completed April 5 1978
Application for plugging filed April 12 1978
Application for plugging approved April 11 1978
Plugging commenced April 5 1978
Plugging completed April 5 1978
Reason for abandonment of well or producing formation
lack of permeability
If a producing well is abandoned, date of last production
N/A 19

Name of Conservation Agent who supervised plugging of this well William T. Owen
Producing formation Depth to top Bottom Total Depth of Well 3040
Show depth and thickness of all water, oil and gas formations.

OIL, GAS OR WATER RECORDS

CASING RECORD

FORMATION	CONTENT	FROM	TO	SIZE	PUT IN	PULLED OUT
				8-5/8	254'	

Describe in detail the manner in which the well was plugged, indicating where the mud fluid was placed and the method or methods used in introducing it into the hold. If cement or other plugs were used, state the character of same and depth placed, from feet to feet for each plug set.

Bottom plug set @ 240' w/35sx.
Top plug set @ 40' w/12sx.
3sx. cement in rat hole.

RECEIVED
STATE CORPORATION COMMISSION
MAY 12 1978
5-12-78
CONSERVATION DIVISION
Wichita, Kansas

(If additional description is necessary, use BACK of this sheet)

Name of Plugging Contractor Gabbert-Jones, Inc.

STATE OF KANSAS COUNTY OF SEDGWICK, ss.
Byron E. Hummon, Jr. (employee of owner) or (owner or operator)
of the above-described well, being first duly sworn on oath, says: That I have knowledge of the facts, statements, and matters herein contained and the log of the above-described well as filed and that the same are true and correct. So help me God.

(Signature) *Byron E. Hummon, Jr.*
1725 Vickers KSB&T Bldg., Wichita, Ks. 67202
(Address)

SUBSCRIBED AND SWORN TO before me this 10th day of May, 19 78

SANDRA L. MENDOZA
STATE NOTARY PUBLIC
SEDGWICK COUNTY, KANSAS

Sandra L. Mendoza
Sandra L. Mendoza Notary Public.

My Commission expires February 13, 1982

GARBERT-JONES, INC.
WICHITA, KANSAS
DRILLERS' WELL LOG

Davis #1
 C-N/2-N/2-NW Sec 20-31S-6W
 Harper County Kansas

Commenced: 3-30-78

Completed: 4-5-78

OPERATOR: HUDSON OIL CO.

Depth		Formation	Remarks
From	to		
0	25	Sand	Ran 6 jts of 8 5/8" csg sat @
25	475	Redbed	254' Cemented w/225 aka
475	1215	Redbed-Shale-Shells	Common 2X Gal - 3X CC
1215	1505	Shale-Shells	FD @ 11:45 p.m. 3-30-78
1505	2755	Shale	
2755	3040	Line	
	3040 - TD		DRY & ABANDONED

STATE OF KANSAS)
) SS
 COUNTY OF SEDGWICK)

I, the undersigned, being duly sworn on oath, state that the above
 Drillers' Well Log is true and correct to the best of my knowledge and belief and
 according to the records of this office.


GARBERT-JONES, INC.

James S. Sutton II
 JAMES S. SUTTON II

Subscribed and sworn to before me this 10th day of April, 1978.

Elizabeth J. Edwards
 ELIZABETH J. EDWARDS-NOTARY PUBLIC

My Commission expires February 6, 1979.

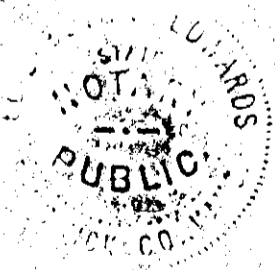

RECEIVED
 STATE CORPORATION COMMISSION
 MAY 12 1978
 5-12-78
 CONSERVATION DIVISION
 Wichita, Kansas