


STATE OF KANSAS
STATE CORPORATION COMMISSION

WELL PLUGGING RECORD

Give All Information Completely
Make Required Affidavit
Mail or Deliver Report to:
Conservation Division
State Corporation Commission
800 Bitting Building
Wichita, Kansas

NORTH

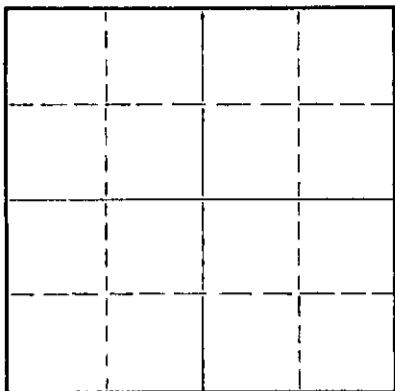

Locate well correctly on above
Section Plat

Harper County, Sec. 33 Twp. 31 Rge. 6 (E) W (W)
Location as "NE/CNW%SW%" or footage from lines NW/4 NW/4 SW/4
Lease Owner Julian Oil & Royalty Co.
Lease Name Wohlschlegel Well No. 1
Office Address State Capitol Sta., Okla. City, Okla.
Character of Well (completed as Oil, Gas or Dry Hole) Dry hole
Date well completed 10-7 19 55
Application for plugging filed 10-7 19 55
Application for plugging approved 10-7 19 55
Plugging commenced 10-7 19 55
Plugging completed 19
Reason for abandonment of well or producing formation

If a producing well is abandoned, date of last production 19
Was permission obtained from the Conservation Division or its agents before plugging was commenced? Yes

Name of Conservation Agent who supervised plugging of this well M. A. Rives, Pratt, Kansas.
Producing formation _____ Depth to top _____ Bottom _____ Total Depth of Well 4936 Feet
Show depth and thickness of all water, oil and gas formations.

OIL, GAS OR WATER RECORDS

CASING RECORD

FORMATION	CONTENT	FROM	TO	SIZE	PUT IN	PULLED OUT
				8-5/8"	181'	None

Describe in detail the manner in which the well was plugged, indicating where the mud fluid was placed and the method or methods used in introducing it into the hole. If cement or other plugs were used, state the character of same and depth placed, from _____ feet to _____ feet for each plug set.

Filled hole to 170 ft. with heavy drilling mud, set plug and cemented with 20 sacks cement. Filled hole to 35 ft. with heavy drilling mud, set plug and cemented to bottom of cellar with 10 sacks cement.

RECEIVED
STATE CORPORATION COMMISSION
OCT 17 1955
10-17-55
CONSERVATION DIVISION
Wichita, Kansas

(If additional description is necessary, use BACK of this sheet)
Name of Plugging Contractor Transit Corporation
Address 1516 Liberty Bank Bldg., Okla. City, Okla.

STATE OF Oklahoma, COUNTY OF Oklahoma, ss.
C. W. Dodson, Agent (XX (as agent of owner) or (as contractor) of the above-described well, being first duly sworn on oath, says: That I have knowledge of the facts, statements, and matters herein contained and the log of the above-described well as filed and that the same are true and correct. So help me God.

(Signature) C. W. Dodson
Oklahoma City, Oklahoma (Address)

SUBSCRIBED AND SWORN to before me this 14th day of October, 1955

June A. Brady
Notary Public.

My commission expires 1-29-59

PLUGGING
FILE SEC 33 T 31 R 6 W
BOOK PAGE 7 LINE 12

TRANSIT CORPORATION
Oklahoma City, Oklahoma
Driller's Log.

Wohlschlegel No. 1

NW NW SW Sec. 33-31S-6W,
 Harper Co., Kans.

Elevation: 1411' GL
 Commenced: 9-12-55
 Completed: 10-6-55

<u>Formation</u>	<u>From</u>	<u>To</u>	
Shale & Clay	0	90	
Shale & Shells	90	175	
Red Bed, Shells & Shale	175	700	Ran 180' of 8-5/8" casing
Shale & Shells	700	1063	cemented w/ 100 sx.
anhydrite	1063	1105	
Shale & Shells	1105	1230	
Lime & Shale	1230	1400	
Lime, Broken	1400	1750	
Lime & Shale	1750	3355	
Sand & Shale	3355	3577	
Lime & Shale	3577	3664	
Shale	3664	3740	
Lime	3740	3985	
Lime & Shale	3985	4077	
Lime	4077	4245	
Shale & Lime	4245	4323	
Lime	4323	4615	
Lime & Chert	4615	4647	
Lime, Chert & Shale	4647	4714	
Shale & Limey Shale	4714	4732	
Shale & Sand	4732	4766	
Hard Sand & Shale	4766	4779	
Hard Sand	4779	4794	
Sand	4794	4817	
Sand & Shale	4817	4833	
Lime & Shale	4833	4888	
Lime	4888	4925	
Lime (Arbuckle)	4925	4936	

T. D. RECEIVED
 STATE CORPORATION COMMISSION
 OCT 17 1955
 10-17-55
 CONSERVATION DIVISION
 Wichita, Kansas

I hereby certify the foregoing to be a true and accurate Driller's Log of the formations encountered in the above well.

TRANSIT CORPORATION
 BY C. W. Dodson
 C. W. Dodson.

Subscribed and sworn to before me this 14th day of October, 1955.

My commission expires Jan. 29, 1959.

Jessie A. Brady
 Notary Public.

PLUGGING
 FILE NO. 33-31S-6W
 PAGE 2 LINE 13