


Give All Information Completely
Make Required Affidavit
Mail or Deliver Report to:
Conservation Division
State Corporation Commission
212 No. Market
Wichita, Kansas 67202

WELL PLUGGING RECORD

NORTH

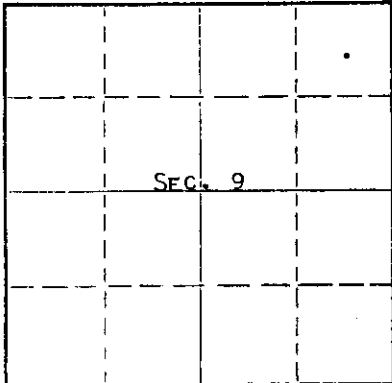

Locate well correctly on above
Section Plat

Location as "NE/CNW/SW" or footage from lines HARPER County, Sec. 9 Twp. 31s Rge. 6 (E) (W)

Lease Owner PETROLEUM, INC.,

Lease Name WOHL SCHLEGEL Well No. 3

Office Address ROUTE 2, GREAT BEND, KANSAS

Character of Well (completed as Oil, Gas or Dry Hole) OIL

Date well completed MARCH 26 19 66

Application for plugging filed NOV. 4 19 70

Application for plugging approved NOV. 5 19 70

Plugging commenced NOV. 9 19 70

Reason for abandonment of well or producing formation DEPLETION OF PRODUCING ZONE

Reason for abandonment of well or producing formation DEPLETION OF PRODUCING ZONE

If a producing well is abandoned, date of last production DECEMBER 4 19 69

Was permission obtained from the Conservation Division or its agents before plugging was commenced? YES

Name of Conservation Agent who supervised plugging of this well G. R. BIBERSTEIN

Producing formation MISSISSIPPI Depth to top Bottom Total Depth of Well 4725' Feet

Show depth and thickness of all water, oil and gas formations.

OIL, GAS OR WATER RECORDS

CASING RECORD

FORMATION	CONTENT	FROM	TO	SIZE	PUT IN	PULLED OUT
MISSISSIPPI	SLIGHT OIL & WATER	4302'	4306'	8-5/8"	216'	NONE
				5-1/2"	4705'	3806'

Describe in detail the manner in which the well was plugged, indicating where the mud fluid was placed and the method or methods used in introducing it into the hole. If cement or other plugs were used, state the character of same and depth placed, from feet to feet for each plug set.

PLUGGED BACK TOTAL DEPTH 4350'. DUMPED SAND FROM 4350' TO 4230', DUMPED 5 SACKS CEMENT FROM 4230' TO 4190'. HEAVY MUD FROM 4190' TO 200', ROCK BRIDGE TO 185', DUMPED 3 1/2 YARDS CEMENT FROM 185' TO BASE OF WELL CELLAR.

RECEIVED
STATE CORPORATION COMMISSION
15-30-70
NOV 30 1970
CONSERVATION DIVISION
Wichita, Kansas

(If additional description is necessary, use BACK of this sheet)
Name of Plugging Contractor SANTA FE PIPE & SUPPLY, INC.,
Address BOX 562, GREAT BEND, KANSAS

STATE OF KANSAS, COUNTY OF BARTON, ss.
LAWRENCE PROFFITT (employee of owner) or (owner or operator) of the above-described

well, being first duly sworn on oath, says: That I have knowledge of the facts, statements, and matters herein contained and the log of the above-described well and that the same are true and correct. So help me God. LAWRENCE PROFFITT, DIST. PROD. FOREMAN

(Signature) [Signature]

ROUTE 2, GREAT BEND, KANSAS
(Address)

Subscribed and sworn to before me this 25 day of NOVEMBER, 19 70.



[Signature]
Notary Public.

15-077-38160-0000

WELL LOG

COMPANY Petroleum, Inc.

SEC. 9 T. 31S R. 6W

FARM Wohlschlegel

NO. 3

LOC. App C NE NE


TOTAL DEPTH 4725'

COUNTY Harper

COMM. 2-18-66

COMP. 3-4-66

CONTRACTOR Garvey Drilling Company

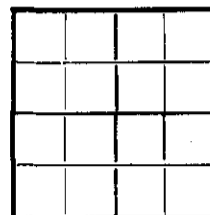

CASING 8 5/8" @ 216' w/225 sx

5 1/2" @ 4705' w/200 sx

ELEVATION 1484' GL

PRODUCTION Mississippi

FIGURES INDICATE BOTTOM OF FORMATIONS

- 15' Surface Soil and Clay
- 216' Red Bed and Shale
- 245' Red Bed
- 460' Red Bed and Shale
- 1075' Shale and Shells
- 1930' Lime and Shale
- 2535' Shale and Lime
- 3002' Lime and Shale
- 3180' Sand, Shale and Lime
- 3680' Lime and Shale
- 3983' Lime
- 4060' Lime and Shale
- 4120' Lime
- 4264' Lime and Shale
- 4292' Mississippi
- 4301' Mississippi Chert
- 4367' Chert
- 4450' Mississippi Lime
- 4479' Chert, Lime, and Shale
- 4543' Chert and Shale
- 4668' Shale and Lime
- 4675' Simpson
- 4682' Simpson Sand
- 4725' Sand
- 4725' RTD

RECEIVED
 STATE CORPORATION COMMISSION
 NOV 30 1970
 CONSERVATION DIVISION
 Wichita, Kansas

State of Kansas }
 County of Barton } SS

I, Sam N. Stephens of Garvey Drilling Company

upon oath state the above and foregoing is a true and correct copy of the log of the Wohlschlegel No. 3 well.

Sam N. Stephens

Subscribed and sworn to before me this 14th day of March 19 66

My Commission Expires: November 5, 1969

Richard D. Boy
 NOTARY PUBLIC